


T.8S., R.38E., W.M.



The location of the div. pt. is 40' S. & 160' W.
from the NE cor. of SE 1/4, SW 1/4 sec. 36.

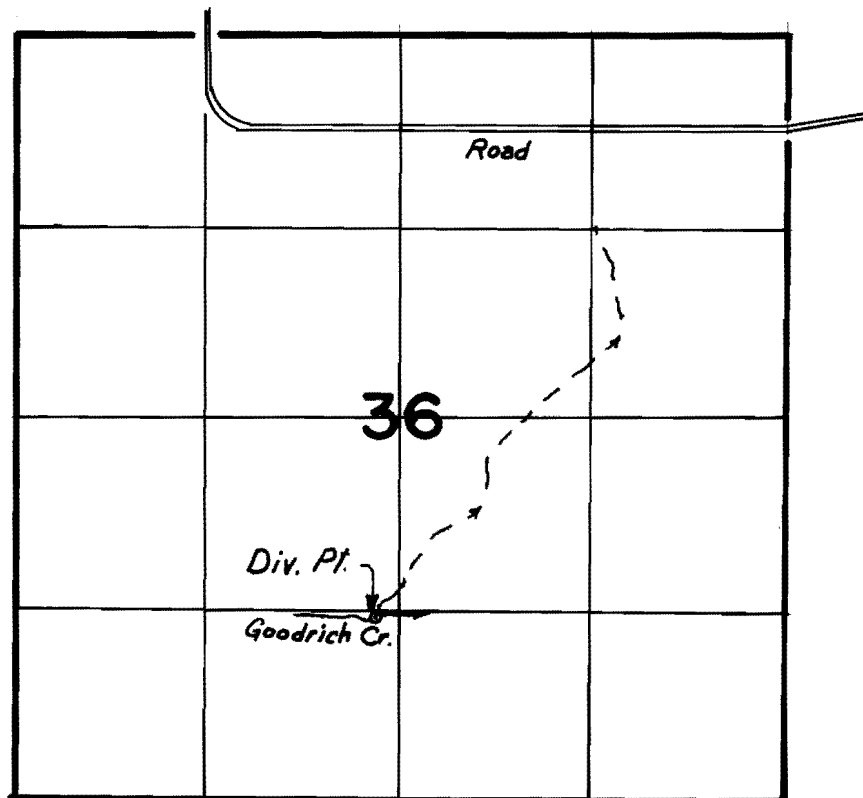

Scale: 1" = 1320'

FINAL PROOF SURVEY
UNDER

TRANSFER 5038

Application No. Permit No.
IN NAME OF

.....DAVID.....H.....COOMBS.....

Surveyed ...10...8... 1987, by Vern Church...