


T.6S. R.2W., W.M

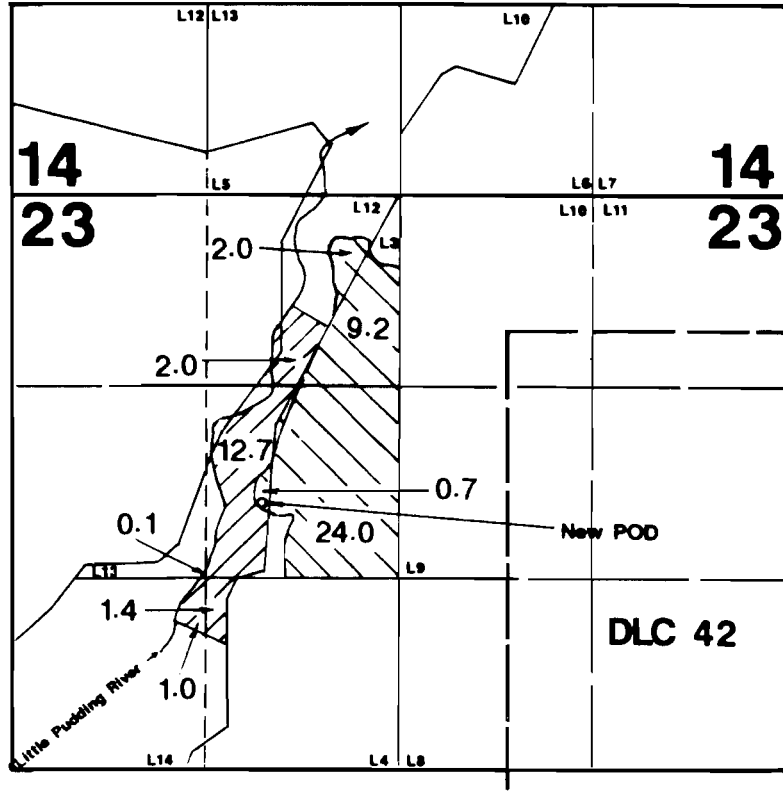

1" = 1320'

Permit # 6535
Permit # 22392

New POD is located 1200'S & 1700'W from the NW corner of DLC 42.

RECEIVED

AUG 25 1999

WATER RESOURCES DEPT
SALEM, OREGON

Final Proof Survey

Transfer #: T-6865

In Name Of

Sinn Bros.

Surveyed on August 10, 1999 by JM Schuette

This Map Was Prepared For The Purpose Of Identifying The Location Of A Water Right Only And Is Not Intended To Provide Legal Dimensions Or Location Of Property Ownership Lines.

