


# T.6S. R.2W., W.M

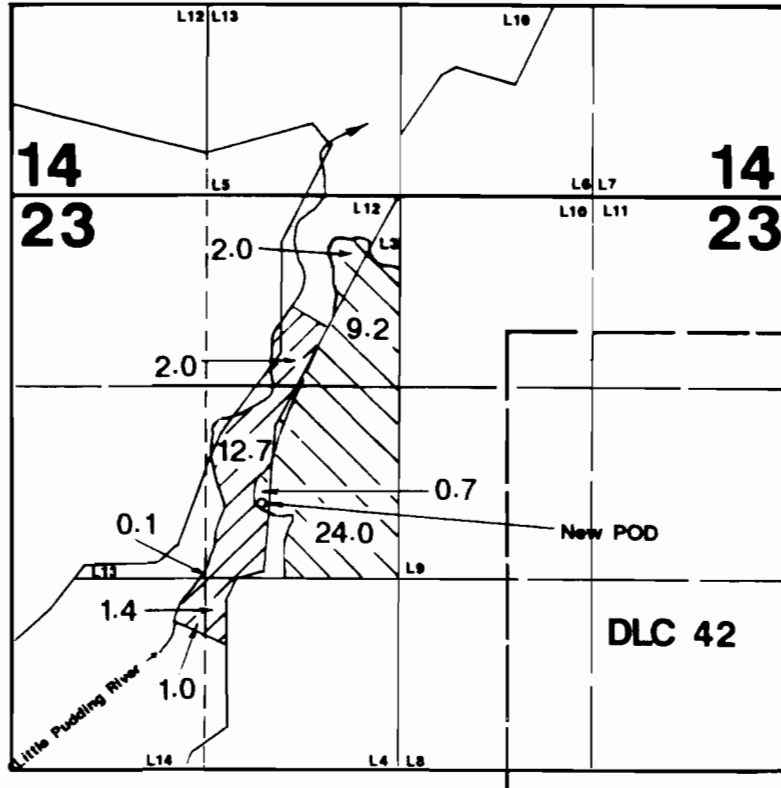

New POD is located 1200'S & 1700'W from the NW corner of DLC 42.

**RECEIVED**

AUG 25 1999

WATER RESOURCES DEPT  

## Final Proof Survey

Transfer #: T-6865

In Name Of

**Sinn Bros.**

Surveyed on August 10, 1999 by JM Schuette

This Map Was Prepared For The Purpose Of Identifying The Location Of A Water Right Only And Is Not Intended To Provide Legal Dimensions Or Location Of Property Ownership Lines.

