


SECTION 13 & 14, T.4S., R.5W., W.M.

YAMHILL COUNTY, OREGON

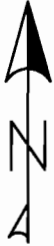


SCALE: 1"=400'

MAP BASE:
ODWR CERT. MAPS
ASSESSORS MAP
FIELD SURVEY
FOR RESEVOIR

RESERVOIR POD IS
S 16°18'48" E
995.34' FROM NW
COR. SECTION 13,
T4S, R5W, WM TO
☉ DAM AT CONDUIT

ALL IN WILLIAM
DAWSON DLC 43

— · — MAIN LINE

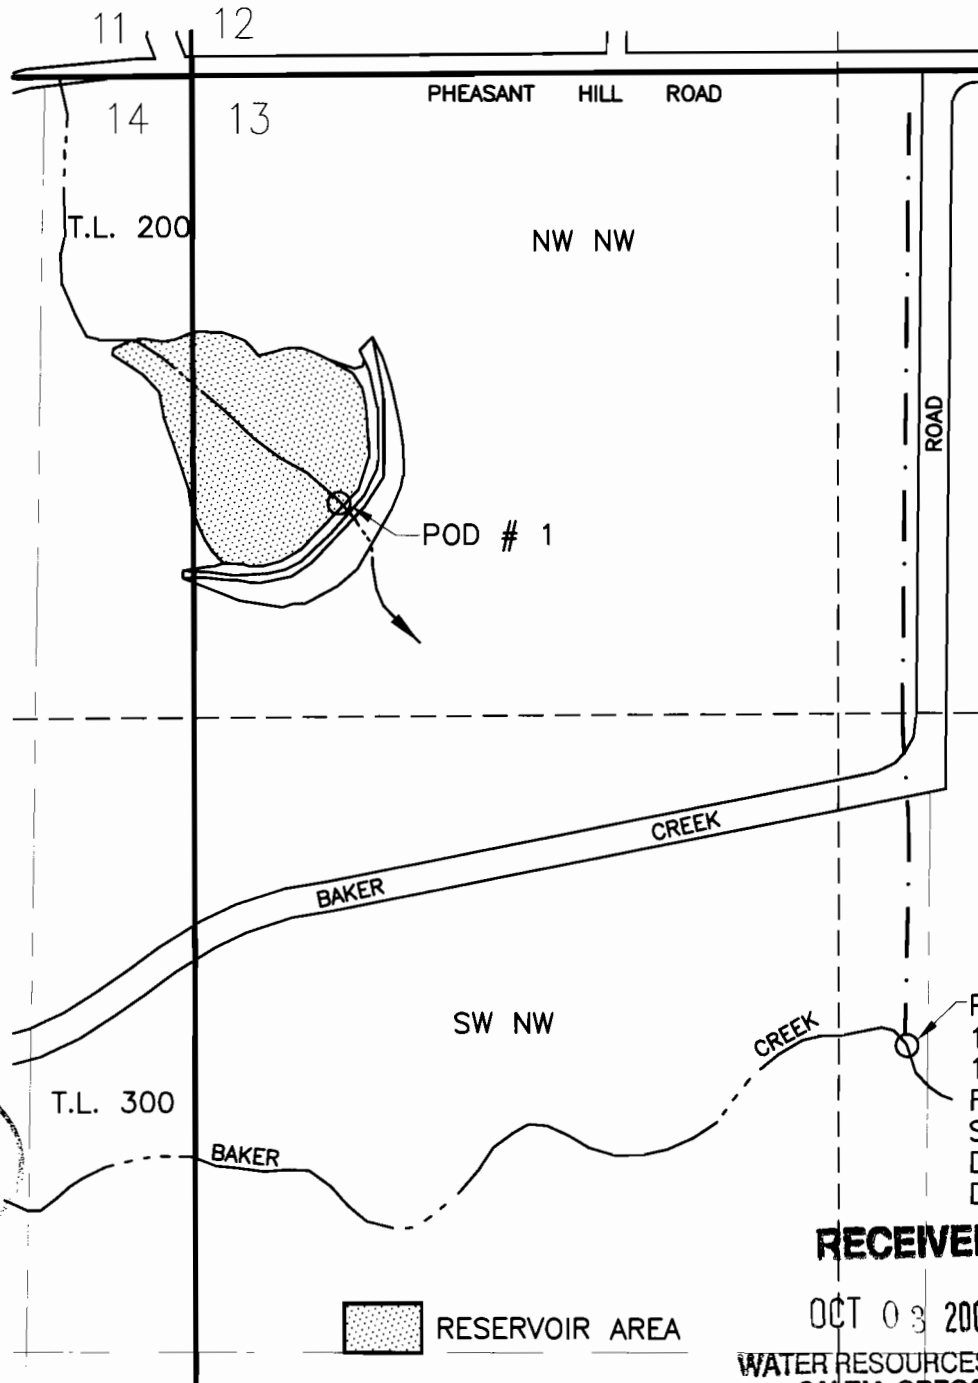

Certified Water Right Examiner
#135
W. Richard Verboort
W. Richard Verboort
Nov. 19, 1987
STATE OF OREGON

POD # 2
1710'N,
1340'W
FROM
SE COR
DAWSON
DLC 43

RECEIVED

OCT 03 2008

WATER RESOURCES DEPT
SALEM, OREGON

PREPERATION OF THIS MAP IS FOR THE
PURPOSE OF IDENTIFYING THE LOCATION OF
THE WATER RIGHT ONLY. THERE IS NO INTENT
TO PROVIDE DIMENSIONS OR LOCATION OF
PROPERTY OWNERSHIP LINES.

CLAIM OF BENEFICIAL USE MAP
SURVEYED 09-23-08



Project: 305-2-027-A
By: W. R. Verboort, P.E.
Date: 09-23-08

WADE & PATRICIA MILLER
13945 PHEASANT HILL ROAD
McMINNVILLE, OR 97128