


T. 39 S., R. 8 W., W.M.
Section 34
Josephine County, Oregon

Final Proof Survey
Transfer T-8082, Permit No. 1970 and 4263
For
Walter A. L. Pierre
P.O. Box 186 O'Brien, Or. 97534

North
Scale 1 inch = 400 ft.
Date - September 26, 2000

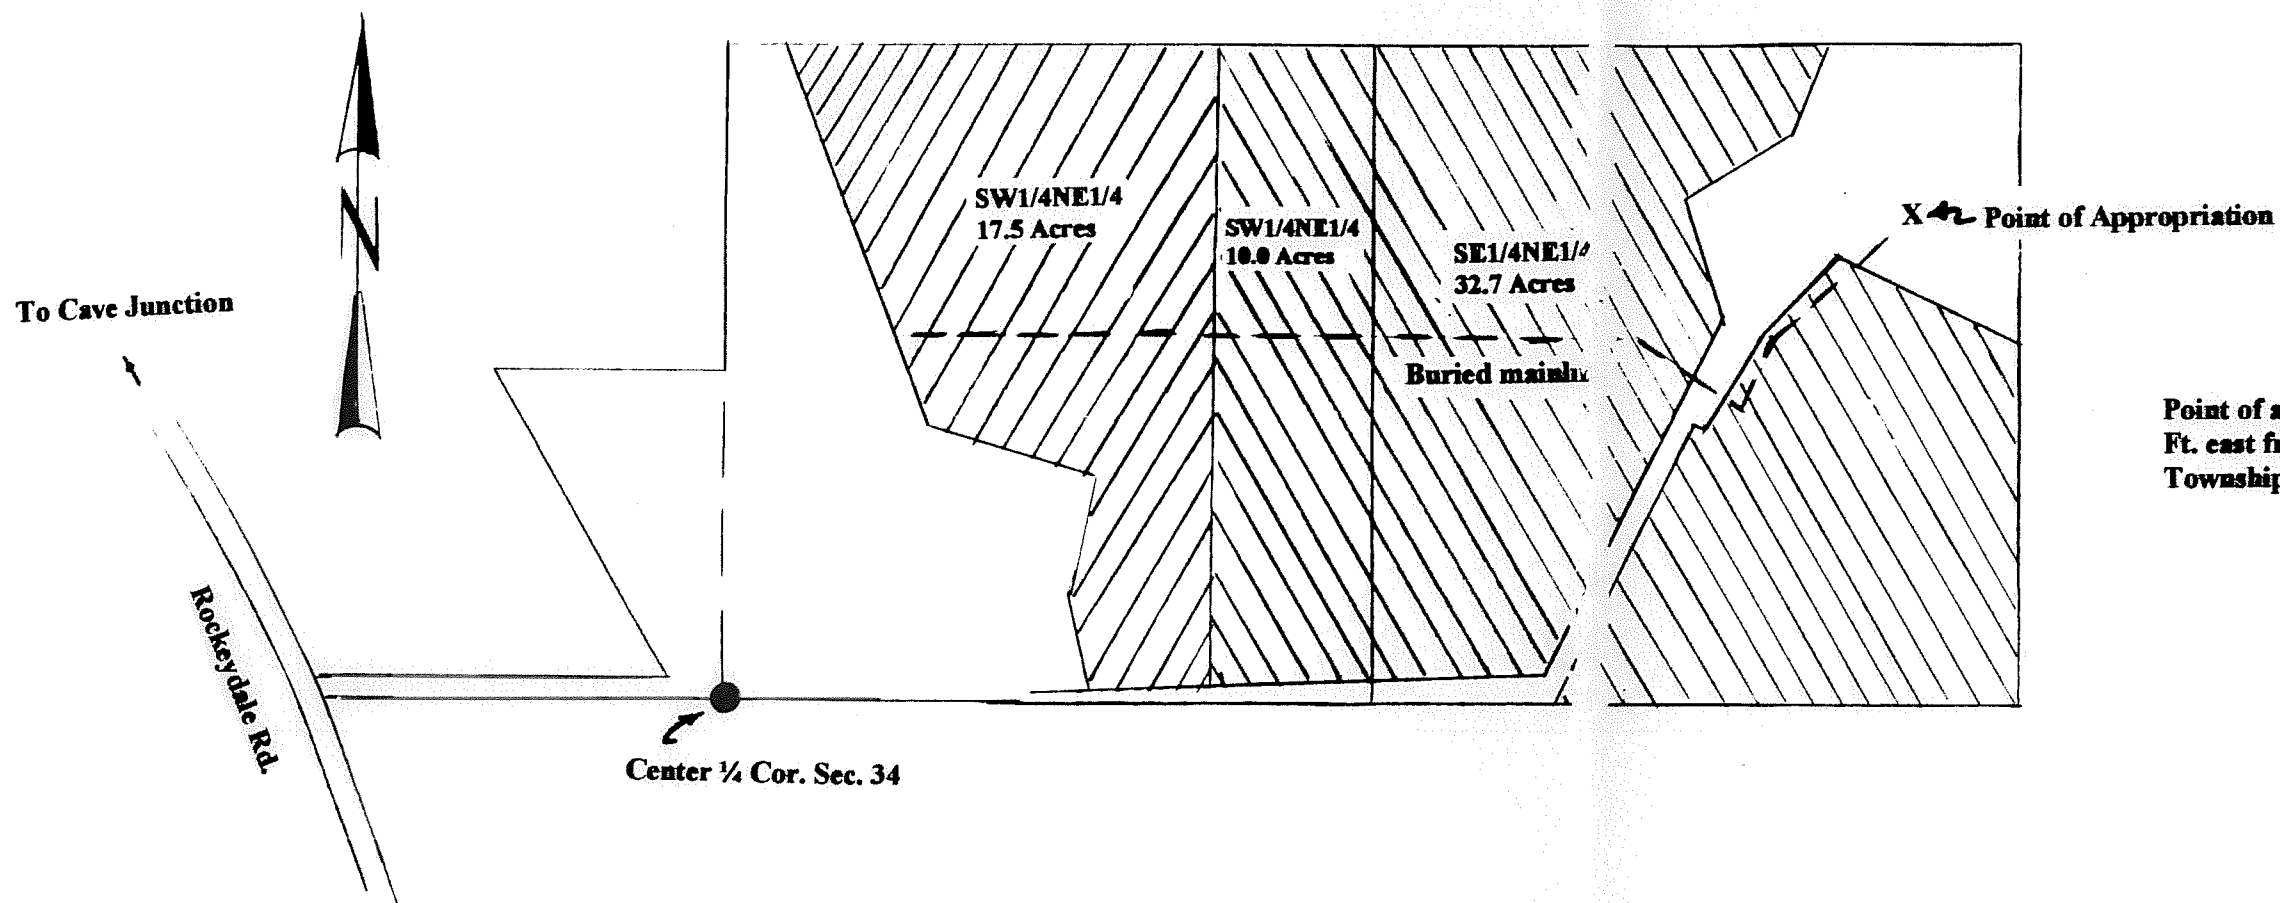

Point of appropriation situated 1006.2 ft. north and 2503.1
Ft. east from the center one-quarter corner of Section 34
Township 39 South, Range 8 West, W. M.

LEGEND


● Found Survey Monument

— Denotes Buried Mainline Pipe

 Denotes area under Permit No. 1970 (Transfer T-8082)

 Denotes area under Permit No. 4263 (Transfer T-8082)

C.W.R.E.
Harold L. Center
2604 David Lane Medford, Or. 97504
Certified Water Rights Examiner No. 152

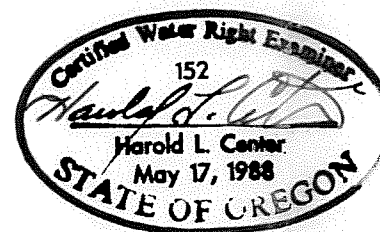

RECEIVED

OCT 06 2000

WATER RESOURCES DEPT.
SALEM, OREGON

This map was prepared for the purpose of
identifying the location of a water right only
and is not intended to provide legal dimensions
or locations of ownership lines.