


T. 30 S., R. 3 W., W.M.

SCALE: 1" = 400'

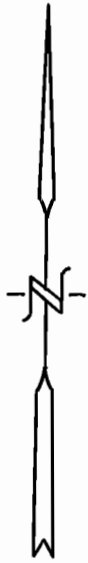

P.O.D.

P.O.D. IS 295 FEET NORTH AND 634 FEET EAST OF THE WEST QUARTER CORNER OF SECTION 24, T. 30 S., R. 3 W., W.M.

THIS MAP IS NOT INTENDED TO PROVIDE LEGAL DIMENSIONS OR LOCATIONS OF PROPERTY OWNERSHIP LINES.

WEST 1/4 COR.
SEC. 24, T. 30 S., R. 3 W., W.M.
FD. 1" IRON PIPE

S.W. 1/16 COR.
FD. 5/8" IRON ROD

T.L. 300

PART OF T.L. 400
GLOCKNER
RESERVOIR

PLACE OF USE
WATERING ROADS WITHIN
DOUGLAS COUNTY.



EXP. 12/31/2013

FINAL PROOF SURVEY

UNDER

TRANSFER APPLICATION T - 9505

IN NAME OF

GLOCKNER INVESTMENT

Surveyed DEC. 21, 2011

by: R.F. BROWN

RECEIVED

FEB 16 2012

**WATER RESOURCES DEPT
SALEM, OREGON**