

T6N, R35E, WM
Section 22
Umatilla County



1 inch = 400 feet

LEGEND


○ **Authorized POA**
Headgate in West Prong Little Walla Walla River located 1290 feet S and 1410 feet W from NE Corner of Section 22

△ **Weir**
Weir controls and measures flow about 20 feet from Authorized POD

□ **Pump**
Centrifugal pump station lifts water into pressurized mainline for conveyance and distribution throughout


--- **Conveyance**
Open ditch from POD to weir. Buried PVC pipelines from weir to pump to sprinklers. Water applied with Nelson 20W impact sprinklers.

▨ **Place of Use**
19.01 acres in NE/4, NE/4 of Section 22

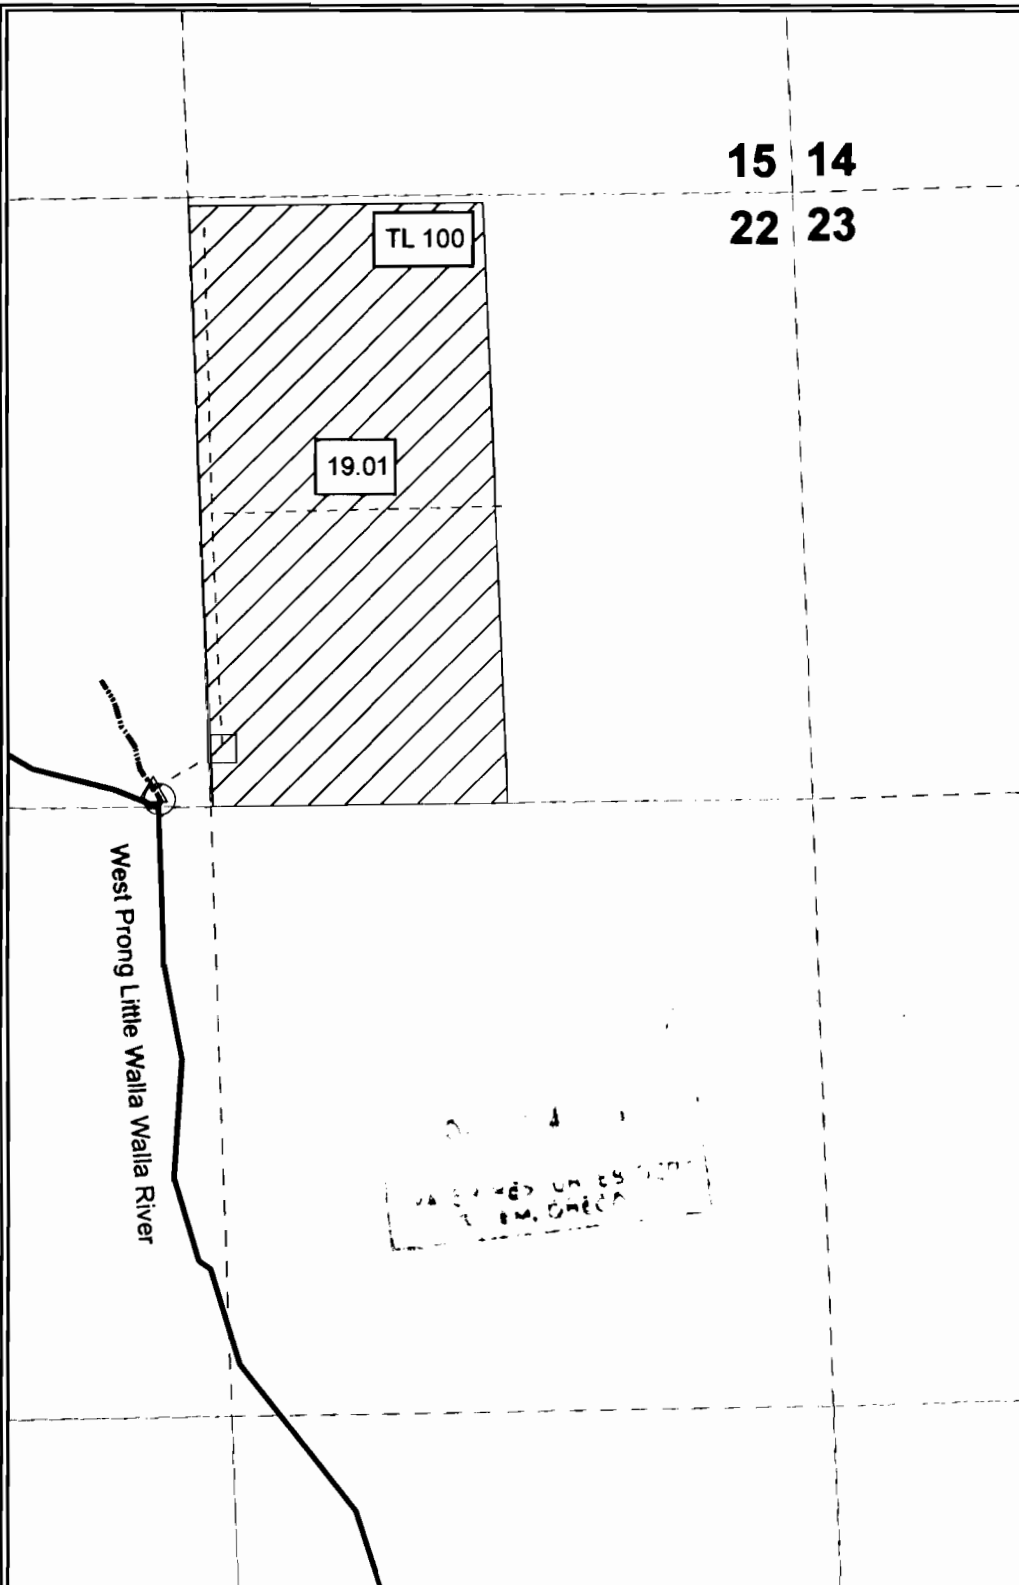

15 14
22 23

The purpose of this map is to identify the location of a water right. It is not intended to provide information regarding the location of property ownership boundary lines.

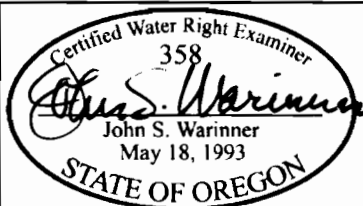

FOUNTAINHEAD
1860 Blue Creek Road
Walla Walla, WA
99362

FINAL PROOF SURVEY
Transfer No. T-8575

in the name of
JIM WALISER ORCHARDS

Revised 21 NOV 2006