


Claim of Beneficial Use: Place of Use Map

Transfer T-8835 (Permit S-9114)

Water Right in the Name of City of Waldport Township 13 South, Ranges 11 & 12 West (W.M.)

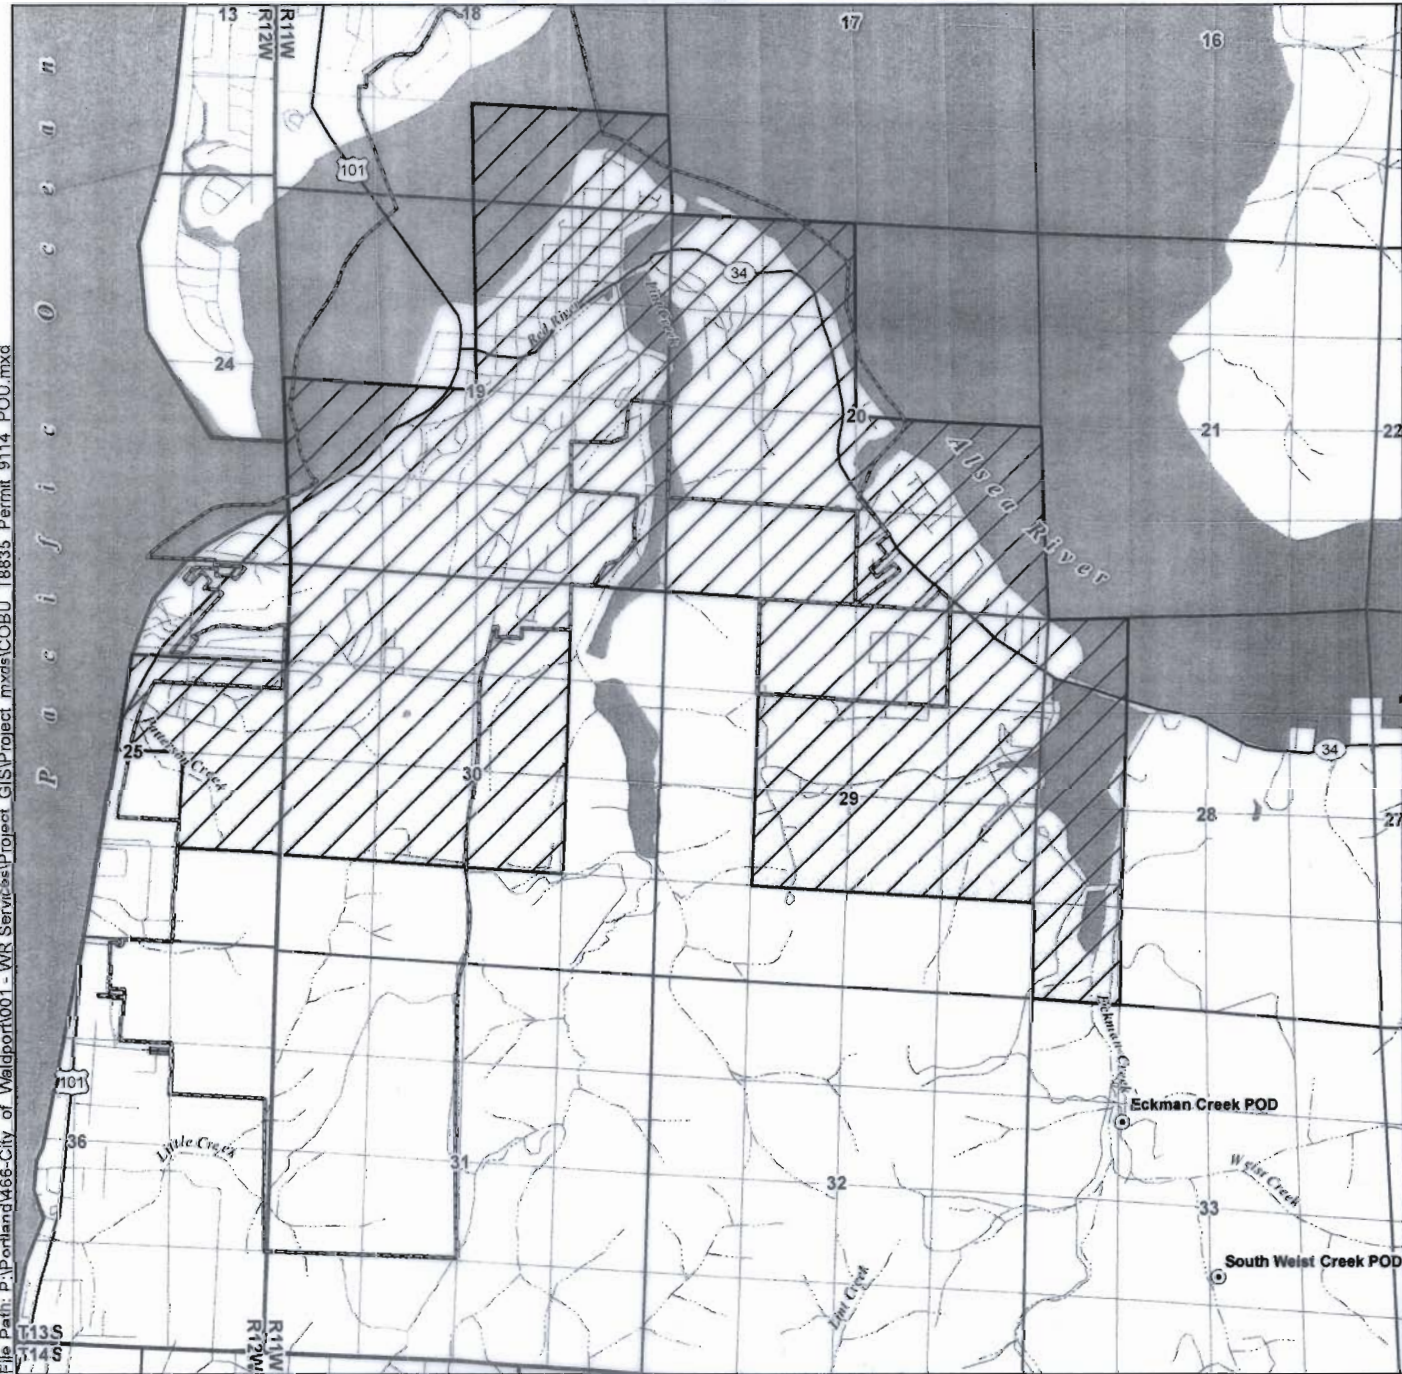

Legend


- Place of Use (POU)
- Point of Diversion (POD)
- Waldport City Limits
- Highways
- Roads
- Watercourses
- Waterbodies

POD Location Descriptions

Eckman Creek POD
North 47° 30' 22" West 1,693 feet from the C 1/4 corner of Section 33, Township 13 South, Range 11 West, (W.M.)

South Weist Creek POD
South 6° 13' 28" East 766 feet from the C 1/4 corner of Section 33, Township 13 South, Range 11 West, (W.M.)

Certified Water Rights Examiner Stamp

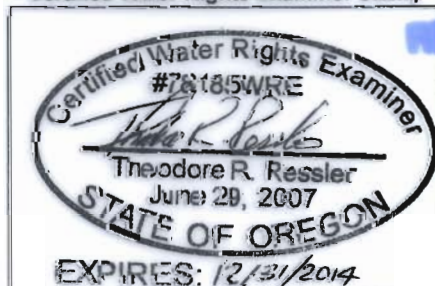


Disclaimer
This map was prepared for the purpose of identifying the location of a water right only and it is not intended to provide legal dimensions or location of property ownership lines.


Map Notes

Date: December 12, 2012
Data Sources: OGIC, US BLM
Prepared By: GSI Water Solutions, Inc.

JAN 17 2013
SALEM, OR

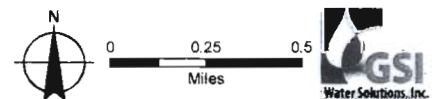

Claim of Beneficial Use: Point of Diversion Map
Transfer T-8835 (Permit S-9114)
Water Right in the Name of City of Waldport
Township 13 South, Range 11 West (W.M.)

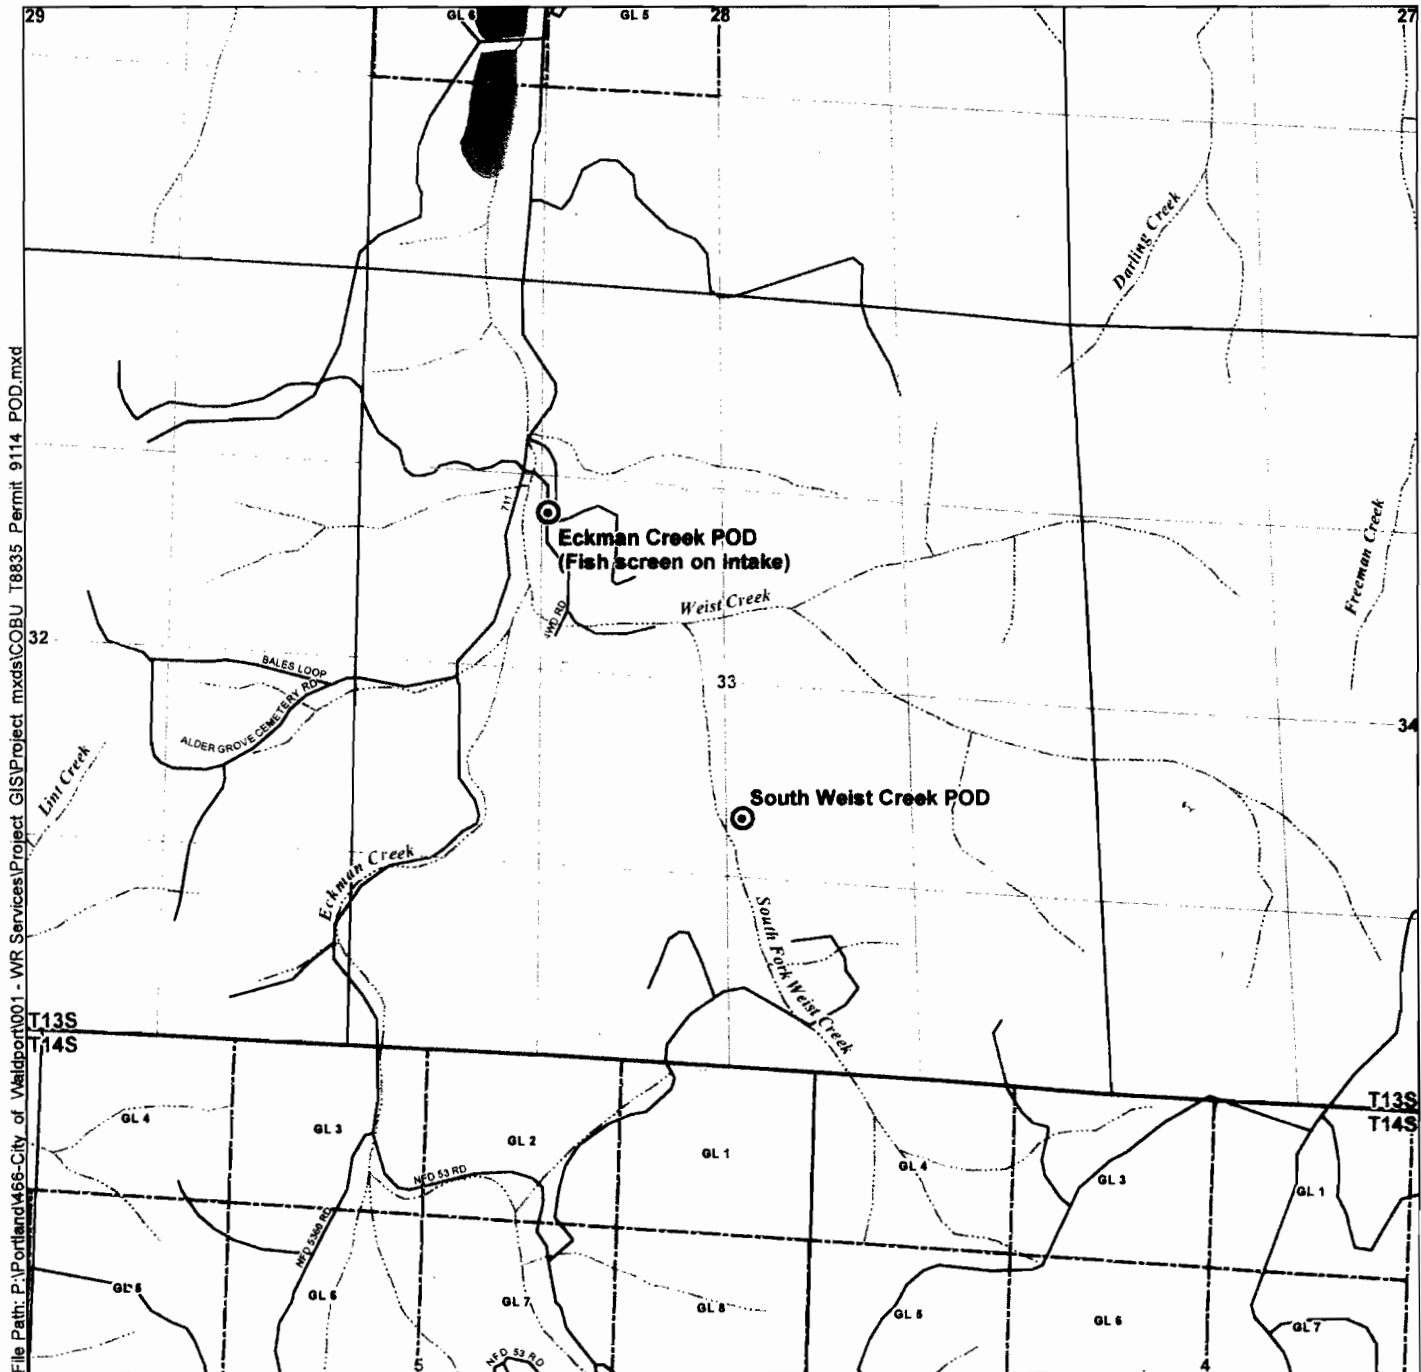

Legend


- Point of Diversion (POD)
- Government Lots
- Roads
- Watercourses
- Waterbodies

POD Location Descriptions

Eckman Creek POD
 North 47° 30' 22" West 1,693 feet from the C 1/4 corner of Section 33, Township 13 South, Range 11 West, (W.M.)

South Weist Creek POD
 South 6° 13' 28" East 766 feet from the C 1/4 corner of Section 33, Township 13 South, Range 11 West, (W.M.)

Certified Water Rights Examiner Stamp

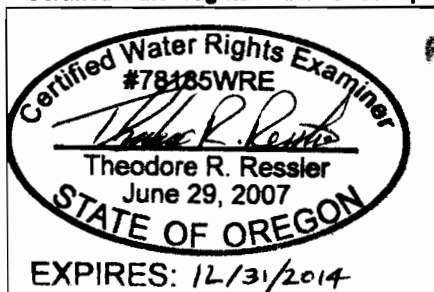

Disclaimer
 This map was prepared for the purpose of identifying the location of a water right only and it is not intended to provide legal dimensions or location of property ownership lines.

RECEIVED BY ONRD

Map Notes

Date: December 12, 2012
 Data Sources: OGIC, US BLM
 Prepared By: GSI Water Solutions, Inc.

JAN 17 2013

SALEM, OR



0 660 1,320
 Feet

