

Claim of Beneficial Use: Place of Use Map Transfer T-8835 (Permit S-10315)

Water Right In the Name of City of Waldport
Township 13 South, Ranges 11 & 12 West (W.M.)



Legend


- Place of Use (POU)
- Point of Diversion (POD)
- Waldport City Limits
- Highways
- Roads
- Watercourses
- Waterbodies

POD Location Descriptions

Eckman Creek POD
North 47° 30' 22" West 1,693 feet from the C 1/4 corner of Section 33, Township 13 South, Range 11 West, (W.M.)

North Weist Creek POD
North 87° 52' East 56 feet from the C-E 1/16 corner of Section 33, Township 13 South, Range 11 West, (W.M.)

Certified Water Rights Examiner Stamp

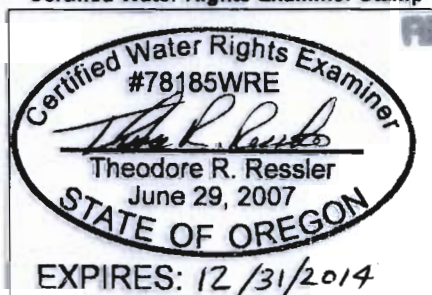

Disclaimer

This map was prepared for the purpose of identifying the location of a water right only and it is not intended to provide legal dimensions or location of property ownership lines.

Map Notes

Date: December 12, 2012
Data Sources: OGIC, US BLM
Prepared By: GSI Water Solutions, Inc.

JAN 17 2013

SALEM, OR




0 0.25 0.5
Miles



Claim of Beneficial Use: Point of Diversion Map Transfer T-8835 (Permit S-10315)

Water Right in the Name of City of Waldport
Township 13 South, Range 11 West (W.M.)

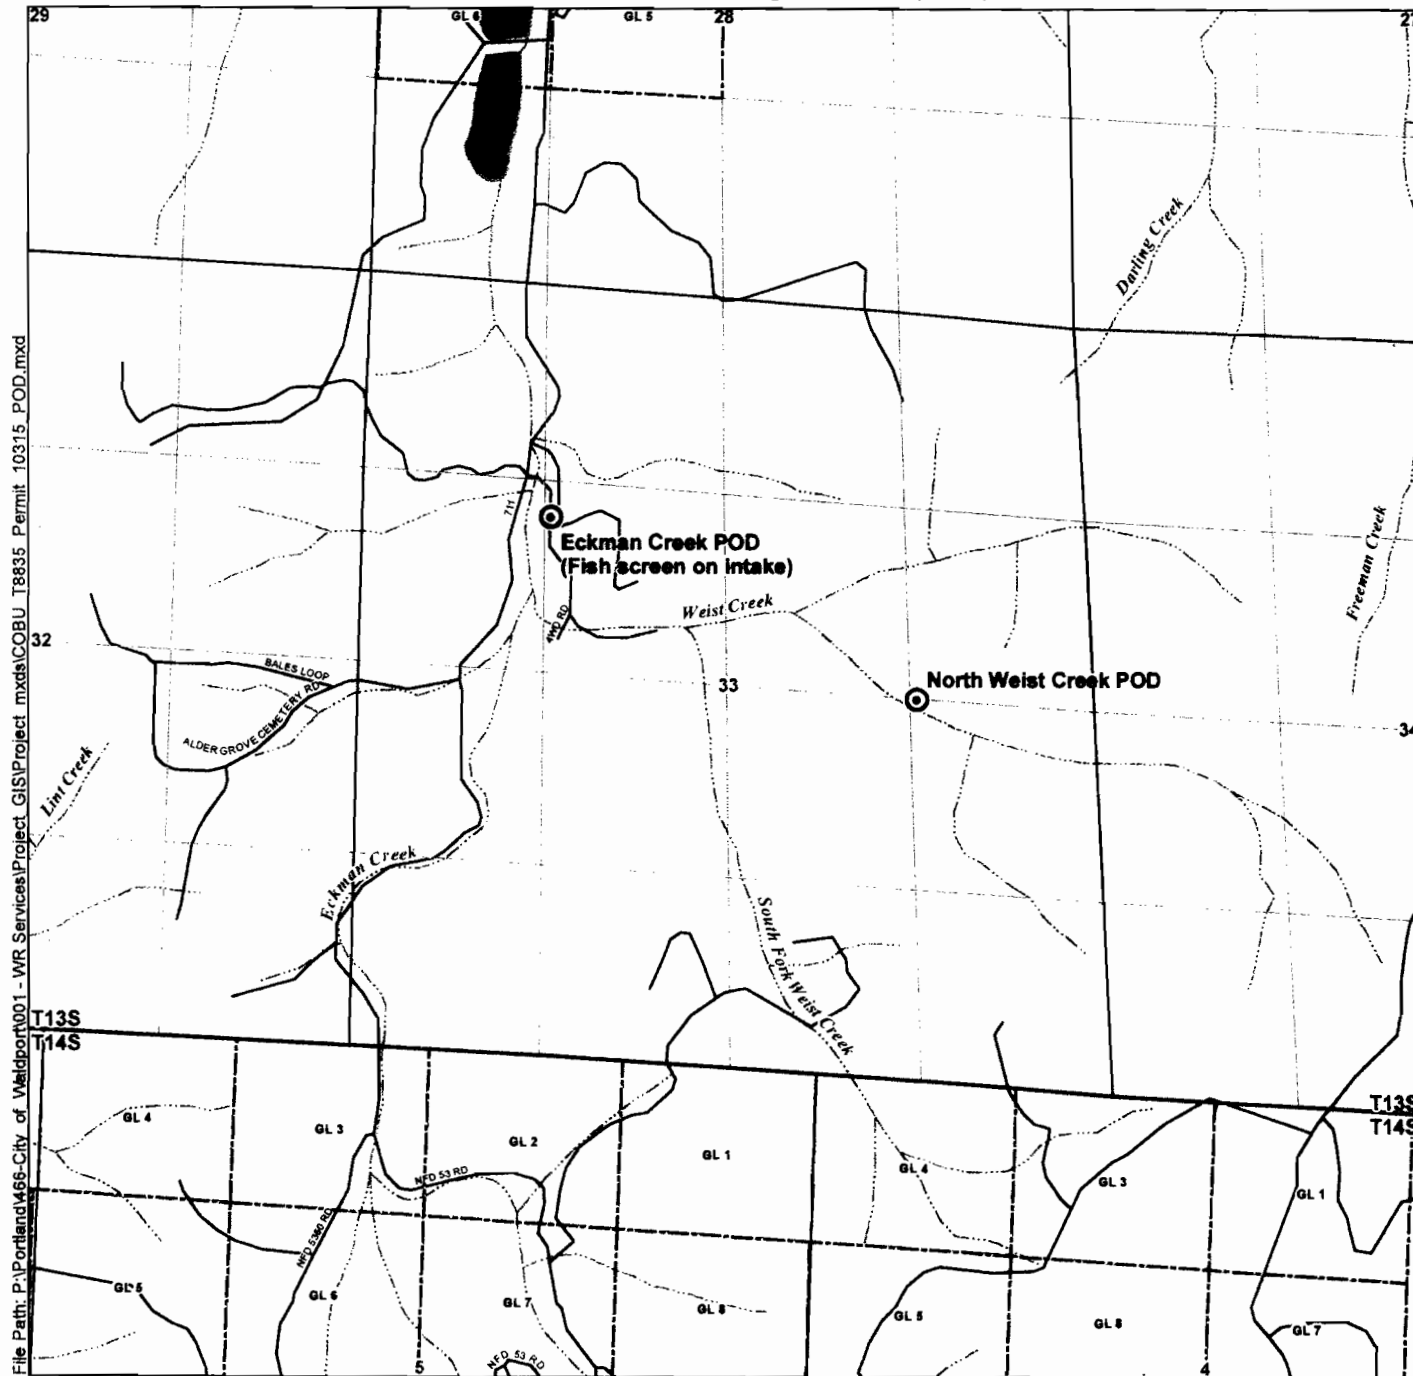

Legend


- Point of Diversion (POD)
- Government Lots
- Roads
- Watercourses
- Waterbodies

POD Location Descriptions

Eckman Creek POD
North 47° 30' 22" West 1,693 feet from the C 1/4 corner of Section 33, Township 13 South, Range 11 West, (W.M.)

North Weist Creek POD
North 87° 52' East 58 feet from the C-E 1/16 corner of Section 33, Township 13 South, Range 11 West, (W.M.)

Certified Water Rights Examiner Stamp

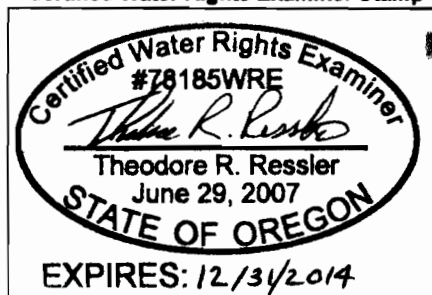

RECEIVED BY ONRD

This map was prepared for the purpose of identifying the location of a water right only and it is not intended to provide legal dimensions or location of property ownership lines.

Disclaimer

Map Notes

Date: December 12, 2012
Data Sources: OGIC, US BLM
Prepared By: GSI Water Solutions, Inc.

JAN 17 2013

SALEM, OR

