



T.6S.R.4W.W.M.

Scale 1"=1320'

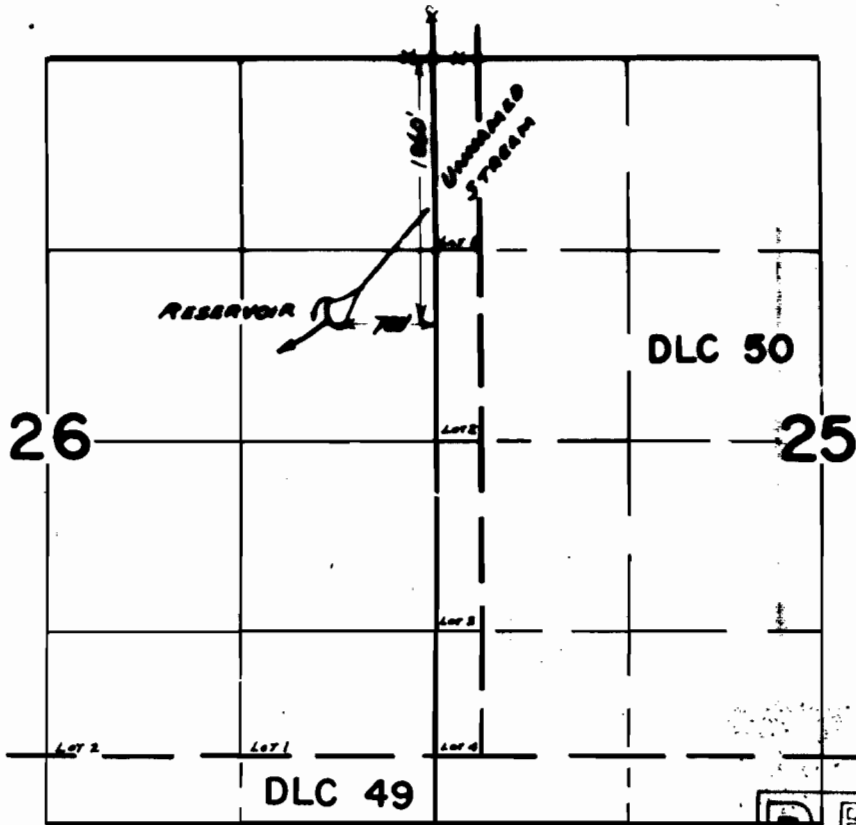


Surveyed Sep 30, 2001

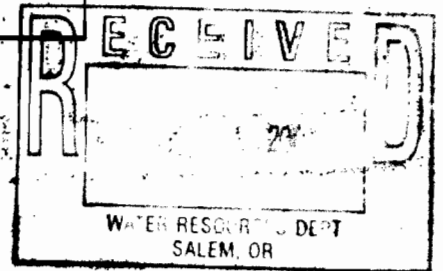

Claim of Beneficial Use Map
for
DAVID KNIELING

T-7273

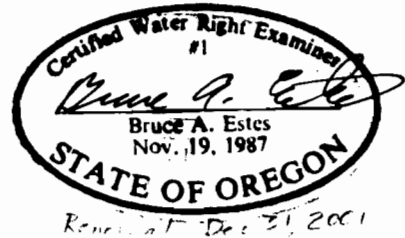

This map is for the purpose of locating a water right only and has no intent to provide legal dimensions or the location of property lines.

ESTES SURVEYS, LLC
PO Box 17519 60382 Arnold Rd
Salem, OR 97305-7519 Bend, OR 97702
(503) 585-7593 (541) 382-7391