
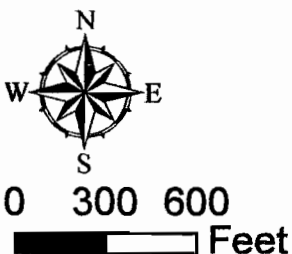


Map 12633, Taxlot 410
Northeast Quarter of the Northeast Quarter of Section 33,
Township 12 South, Range 6 West, Willamette Meridian

Benton County, Oregon

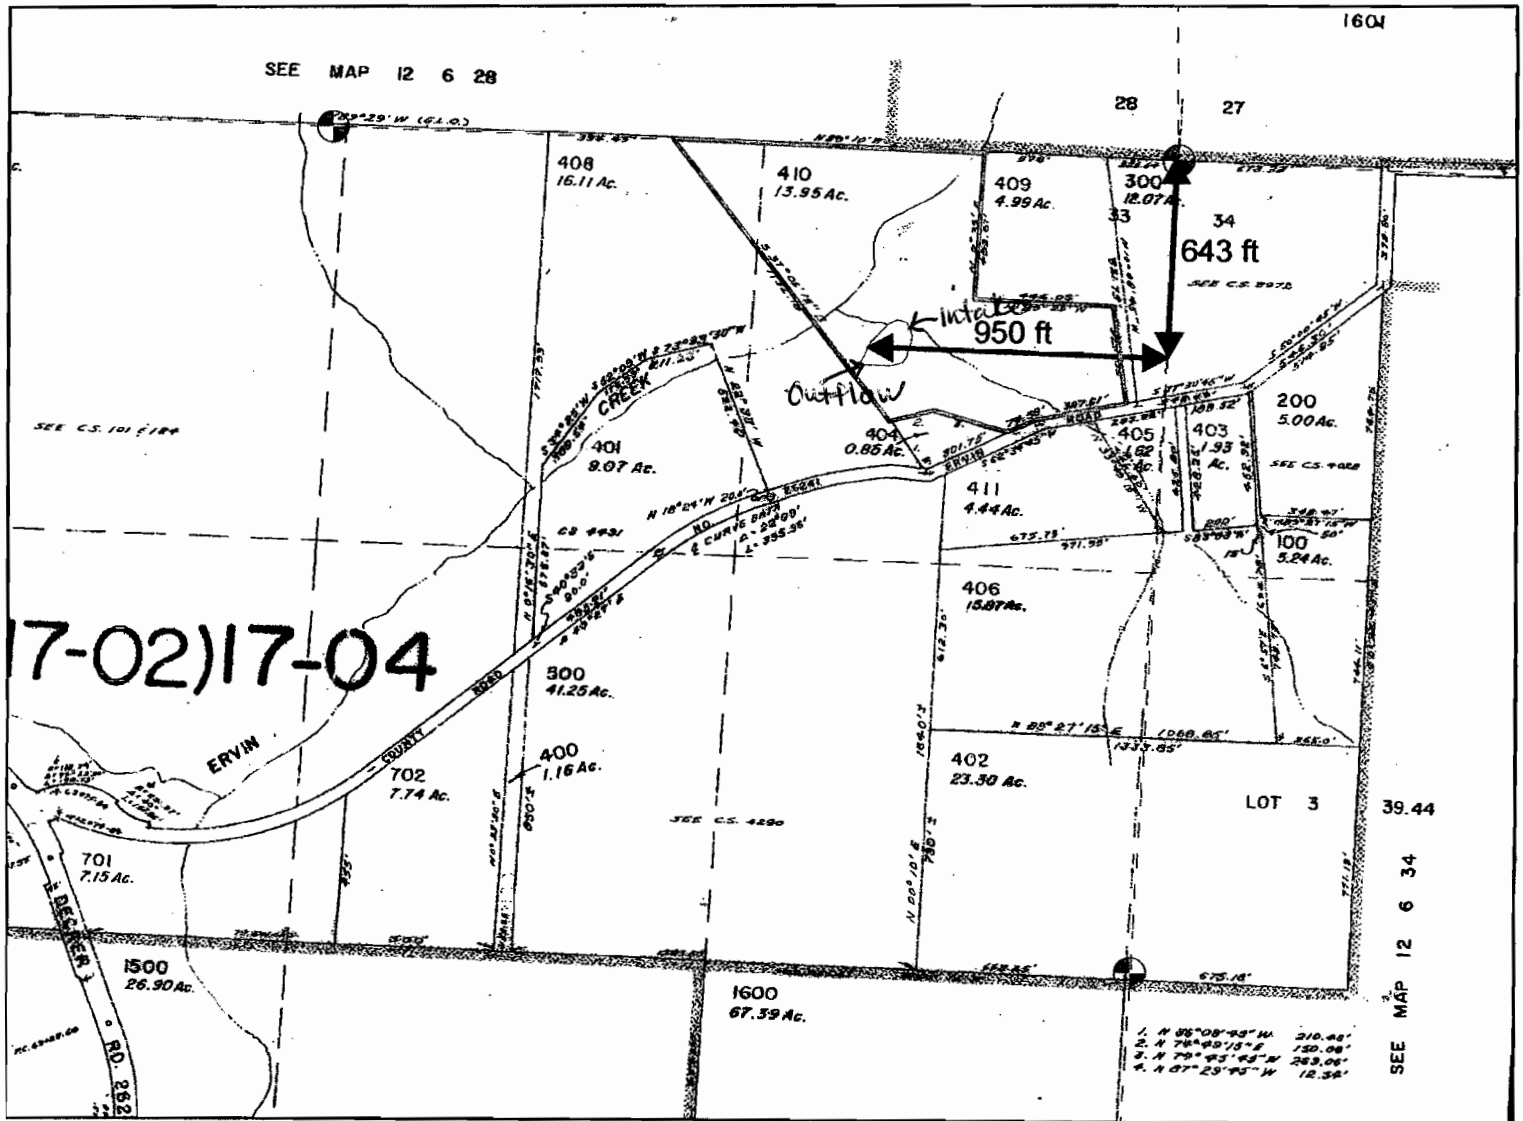

(1 inch = 600 feet)

Alba, David & Deborah

RECEIVED

JAN 24 2012

**WATER RESOURCES DEPT
 SALEM, OREGON**

RECEIVED

MIL 31 2008

**WATER RESOURCES DEPT.
 SALEM, OREGON**



This product is for informational purposes and may not have been prepared for, or be suitable for legal, engineering, or surveying purposes.

Users of this information should review or consult the primary data and information sources to ascertain the usability of the information.