

SECTION 14 T.27S. R.6W. W.M.
DOUGLAS COUNTY

REVISED ON
8-23-95


NW
27 6 14
& INDEX
ROSEBURG

1"=400'

RECEIVED

JUL 30 1996

WATER RESOURCES DEPT.
SALEM, OREGON

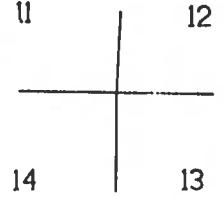


CANCELLED PARCEL NO.'S.

- 300
- 301
- 302
- 201
- 101

WATER RESOURCES DEPT.
SALEM, OREGON

AUG 19 1996

RECEIVED

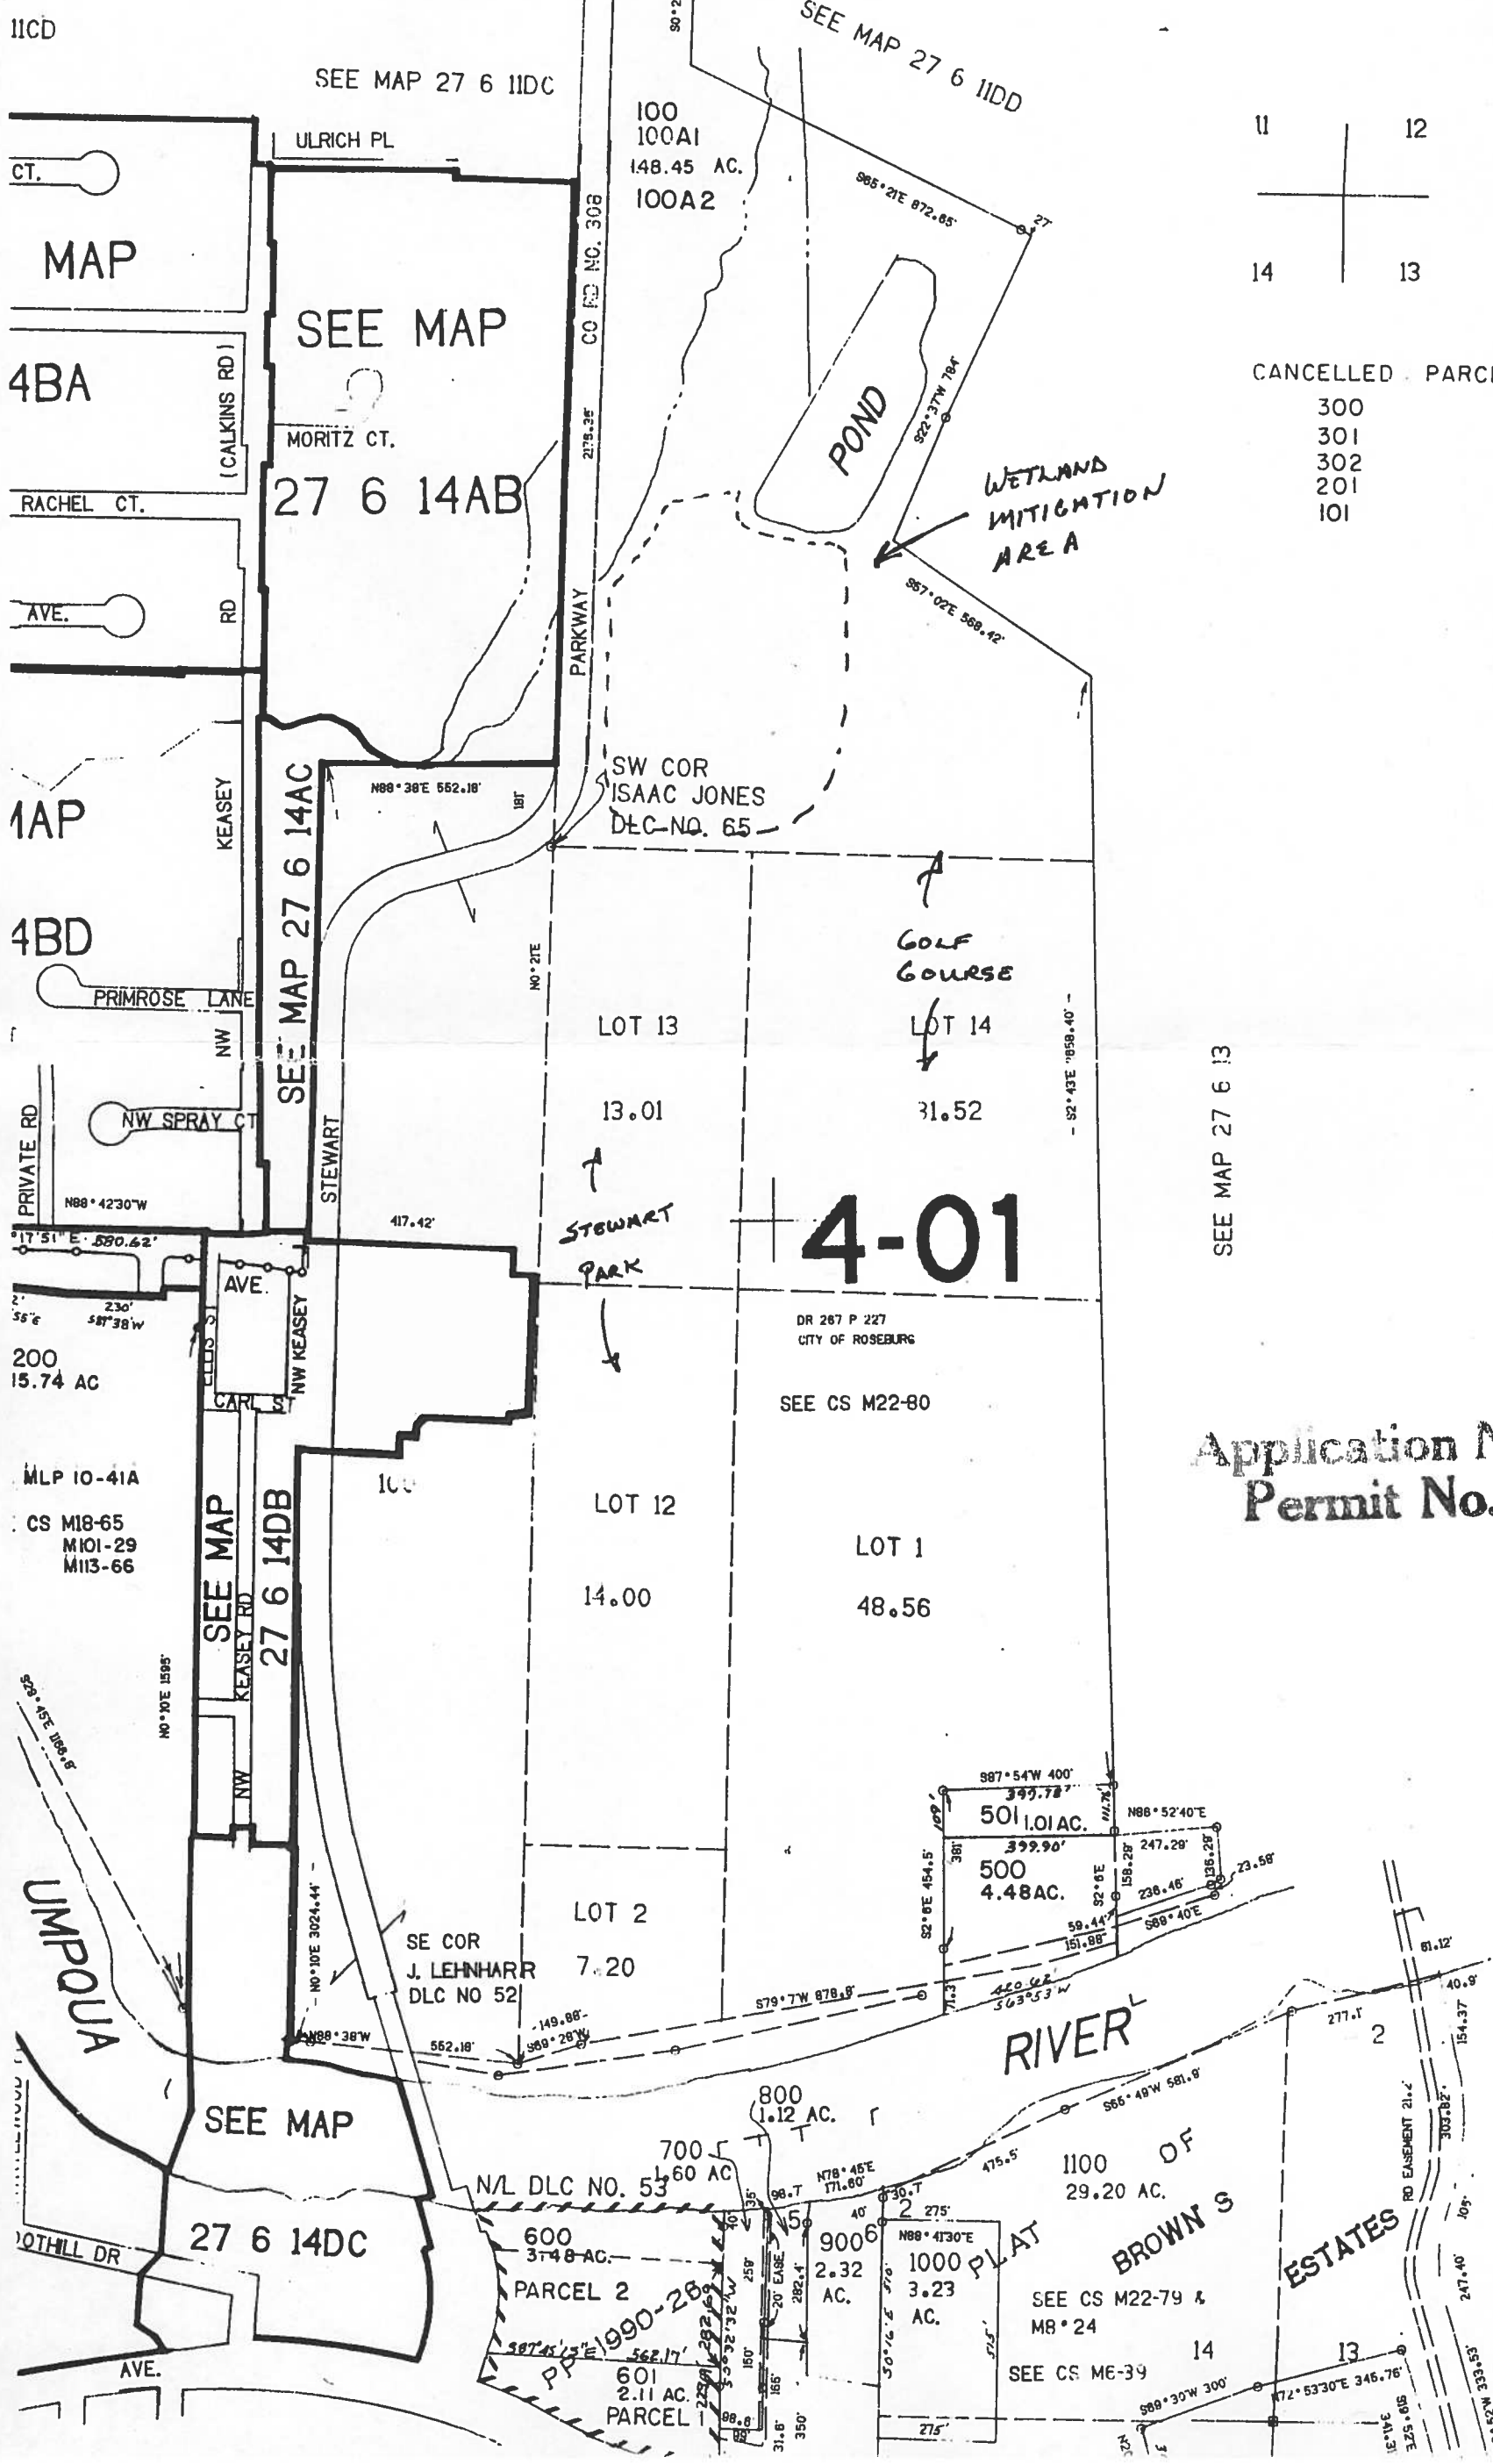

4-01

SEE MAP 27 6 13



580.000

Application No. *R-81555*
Permit No. ~~R12213~~
R12239

SEE MAP 27 6 13CC

NW
27 6 14

S. Duck Pond - Ap# R-81555; Per# R-12239

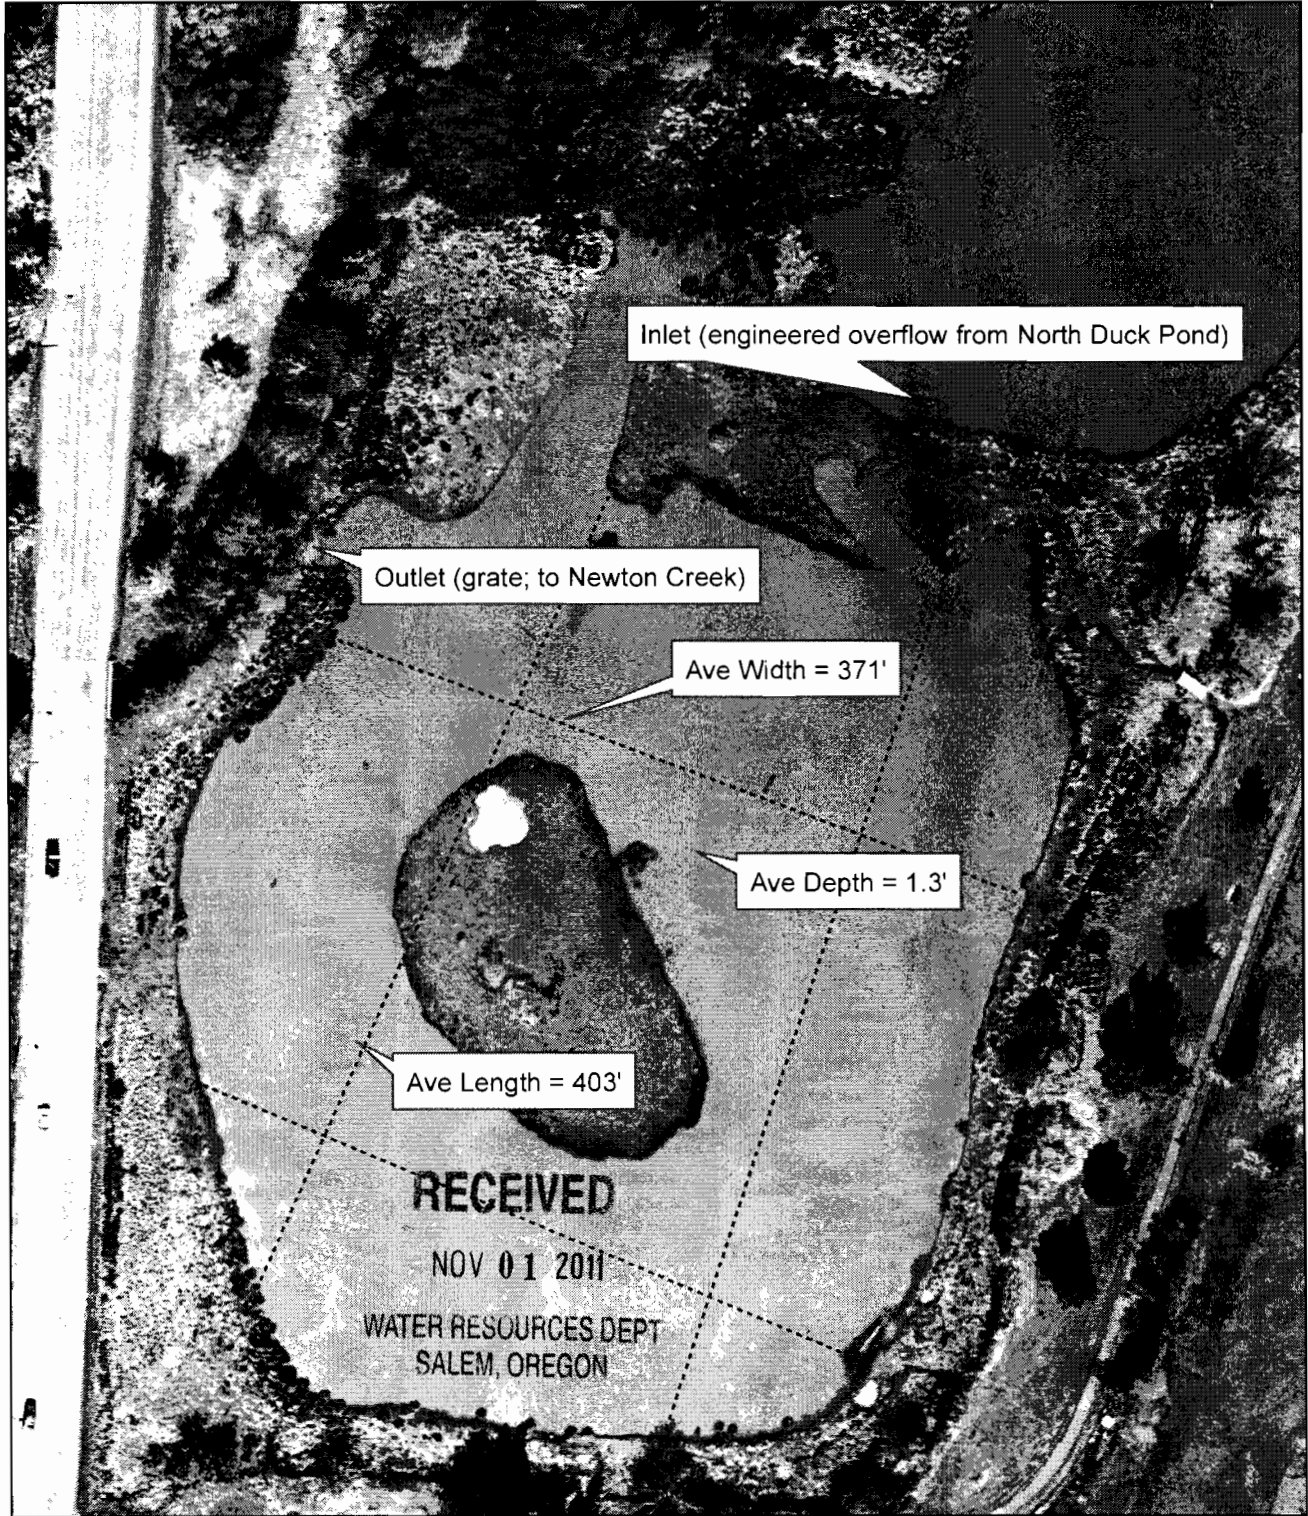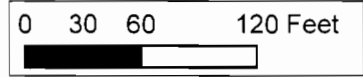

Water Resources Department

