


T. 5 & 6 S., R. 1 E., W. 1 M.

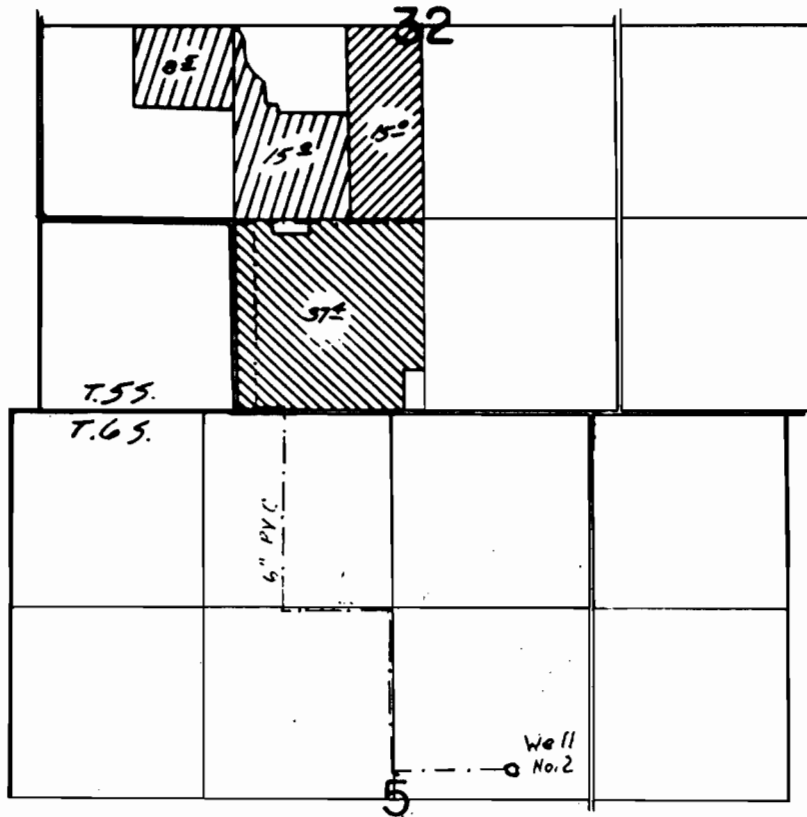

Scale
4" = 1 Mi

Well loc. 210' N & 820' E from C. 1/4 Cor. Sec. 5

WATER RIGHT MAP FOR
T-6422
ROBERT FESSLER

THIS MAP WAS PREPARED FOR THE PURPOSE OF IDENTIFYING THE LOCATION OF A WATER RIGHT ONLY AND IS NOT INTENDED TO PROVIDE LEGAL DIMENSIONS OR LOCATION OF PROPERTY OWNERSHIP LINES.

