

CLAIM OF BENEFICIAL USE AND SITE REPORT

Located in the SE¼ SE¼ of Section 5
Township 23 South, Range 12 West, W.M.
Coos County, Oregon
TRANSFER 9353

Prepared For: Lola K. Messerle Trust
Prepared By: Dennis Goude
Date Prepared: February 24, 2004

NOTE:

The P.O.D. an intake submersible pump and is located 828 feet North and 1052 feet West from the Southeast corner of Section 5.

LEGEND

P.O.B.

P.O.D.



PIPE



Scale 1" = 200 Feet

Assessors Scale

NORTH TENMILE LAKE
(Blacks Arm)

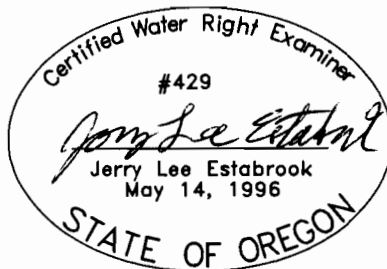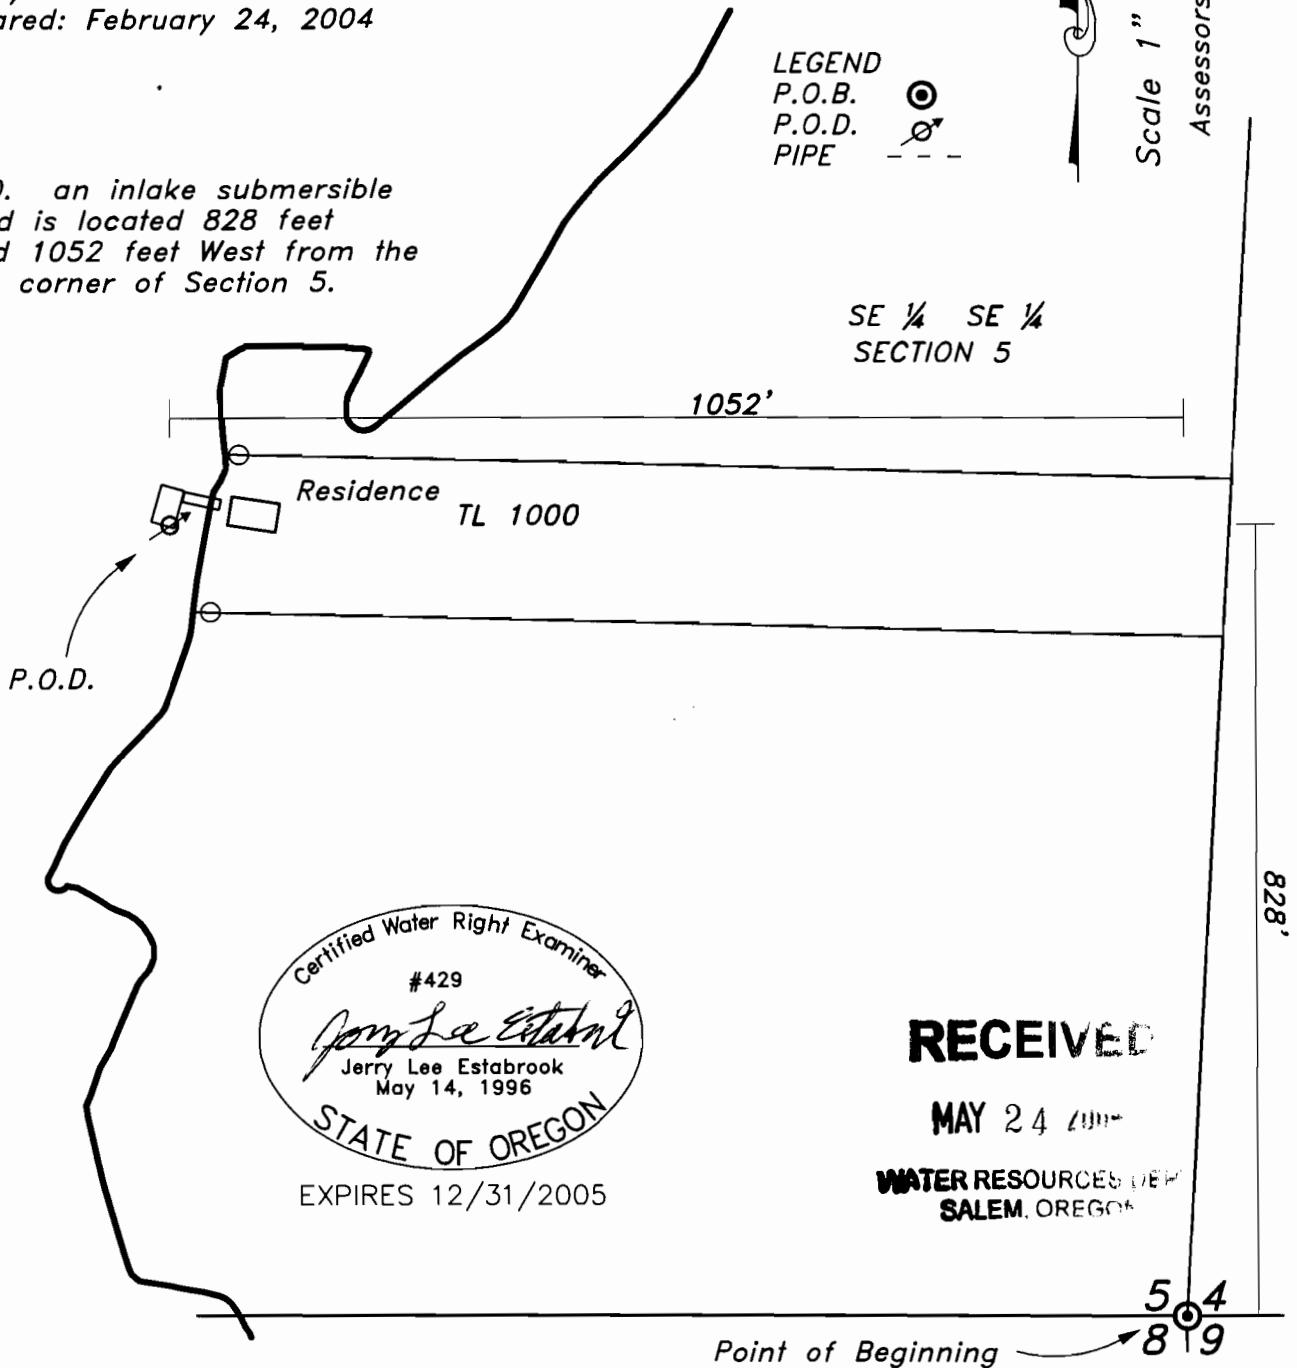

EXPIRES 12/31/2005

RECEIVED

MAY 24 2004

WATER RESOURCES DEPT
SALEM, OREGON

Point of Beginning

EXAMINERS DISCLAIMER STATEMENT

The preparation of this map was for the purpose of identifying the location of the Water Right only and has no intent to provide dimensions or location of property ownership lines.

Stuntzner Engineering
& Forestry, L.L.C.

ENGINEERING • LAND SURVEYING • FORESTRY
PLANNING • WATER RIGHTS

705 South 4th St.
Post Office Box 118
Coos Bay, Oregon 97420

Phone: (541) 267-2872
Fax: (541) 267-0588