



CLAIM OF BENEFICIAL USE
 FOR: DON W. DEBUSK
 & VIRGINIA C. DEBUSK
 BY: DUANE W. KIRBY
 TRANSFER NO T-9152
 T27S, R4W W. M. SEC 13
 TAX LOT 400

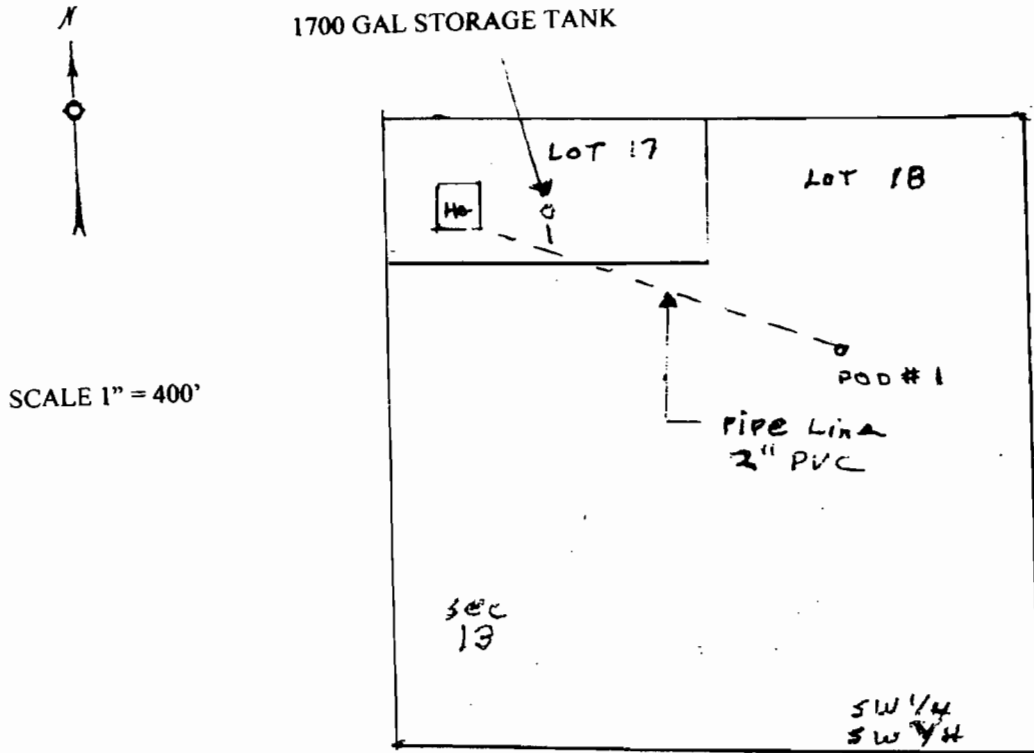

POD NO 1 IS 839 FEET NORTH
 & 922 FEET EAST FROM SW
 CORNER, SEC 13

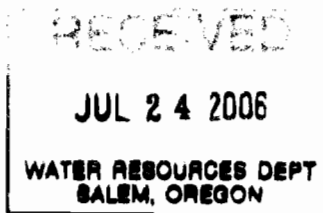

THE PURPOSE OF THIS MAP IS TO
 IDENTIFY THE LOCATION OF THE
 WATER RIGHT. IT IS NOT INTENDED
 TO PROVIDE INFORMATION RELATIVE
 TO THE LOCATION OF PROPERTY
 OWNERSHIP BOUNDARY LINES.