
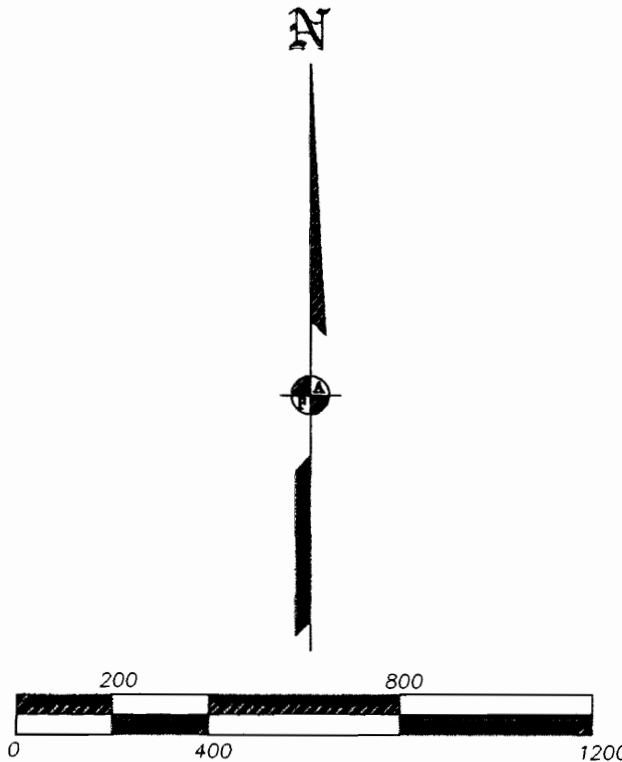
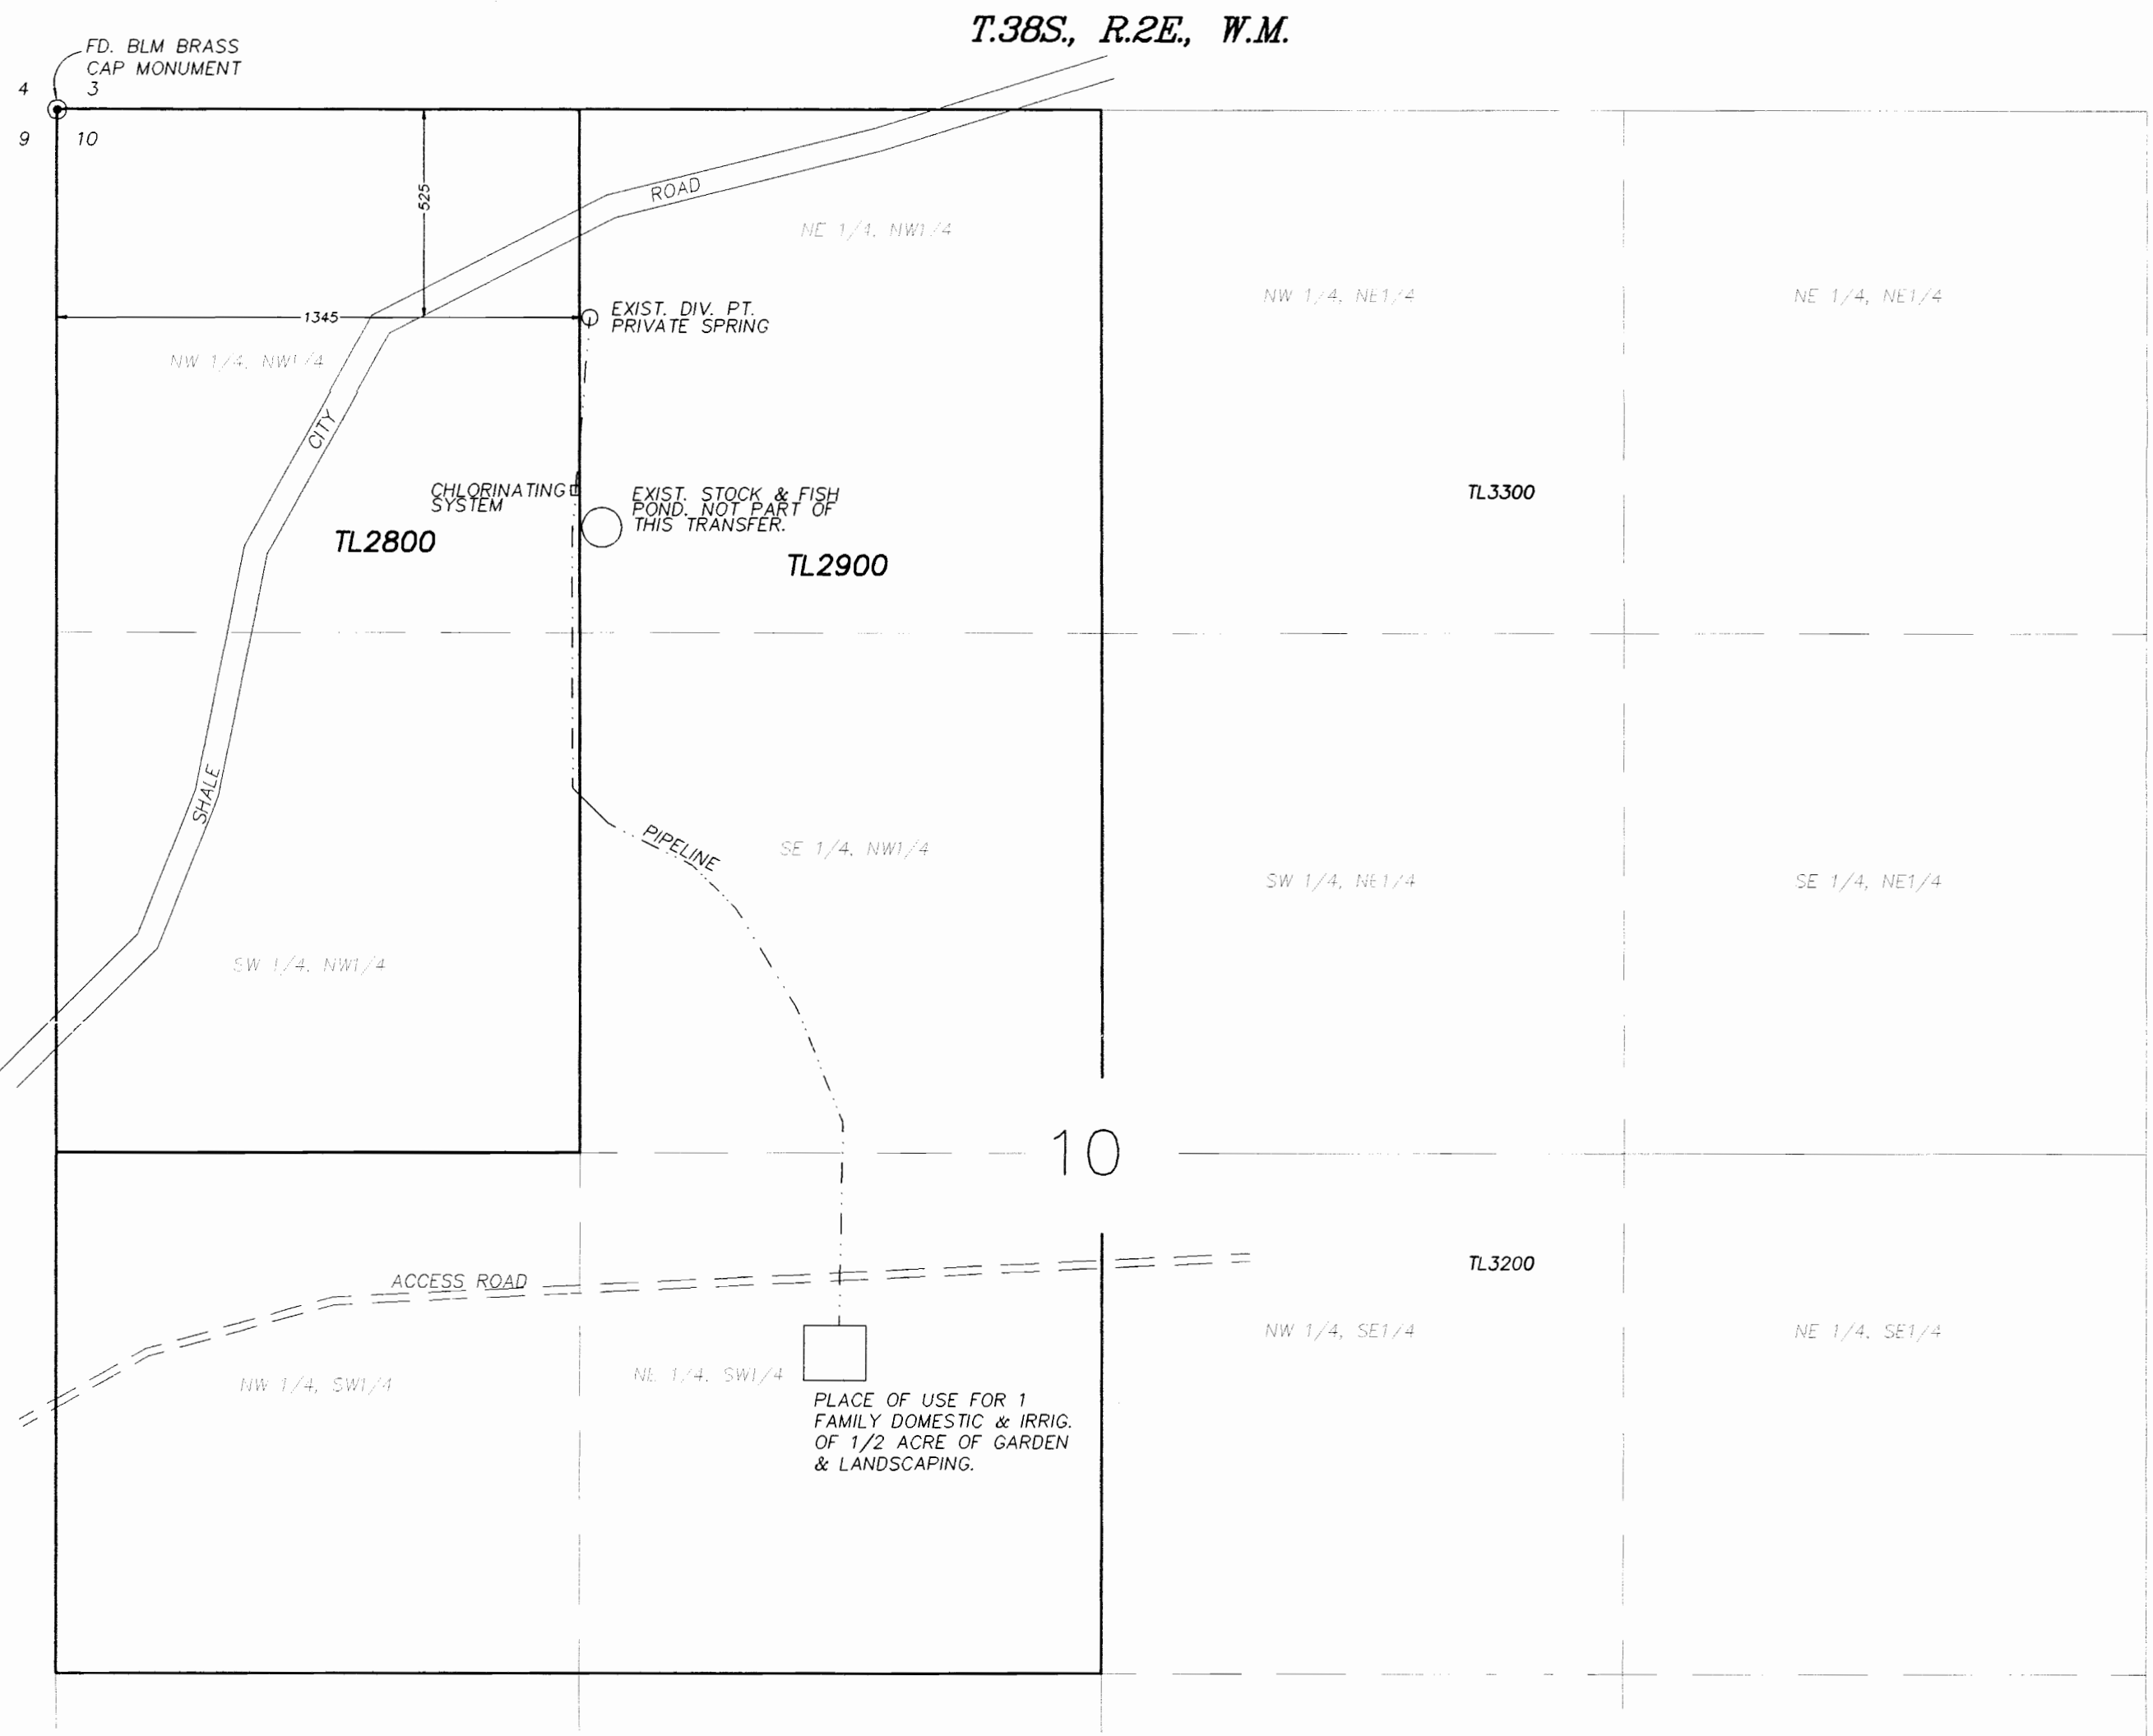


FINAL PROOF MAP
UNDER T-8522

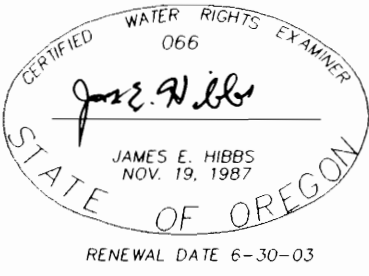

THE PREPARATION OF THIS MAP IS TO IDENTIFY THE WATER RIGHT ONLY AND IS NOT INTENDED TO PROVIDE LEGAL DIMENSIONS OF PROPERTY OWNERSHIP LINES.

	TITLE FINAL PROOF MAP UNDER T-8522	DATE 27 NOV 2002
	FOR: WITT & WILLOW, LLC 658 SHALE CITY ROAD ASHLAND, OR 97520 PH: (541) 890-1998	SCALE: 1 inch : 400 feet
	L.J. FRIAR & ASSOCIATES P.C. CONSULTING LAND SURVEYORS 816 W. 8TH ST., MEDFORD, OR. (541) 772-2782	DRAWN BY: JEH CHK BY: ORIGIN: ROTATION: 0 JOB#: 99288FM
		Sheet 1 of 1.