



CLAIM OF BENEFICIAL USE MAP
FOR
BEATRICE RUBENFELD
TAX LOT 102 MAP T10S, R8W, W.M., SEC25
August 10, 2011

EXHIBIT A
TRANSFER T-7282
CERTIFICATE S-30293

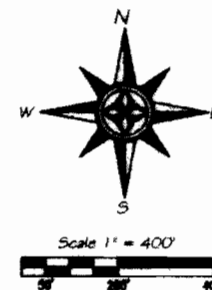

THIS MAP IS NOT INTENDED TO
 PROVIDE LEGAL DIMENSIONS OR
 LOCATION OF PROPERTY
 OWNERSHIP LINES.

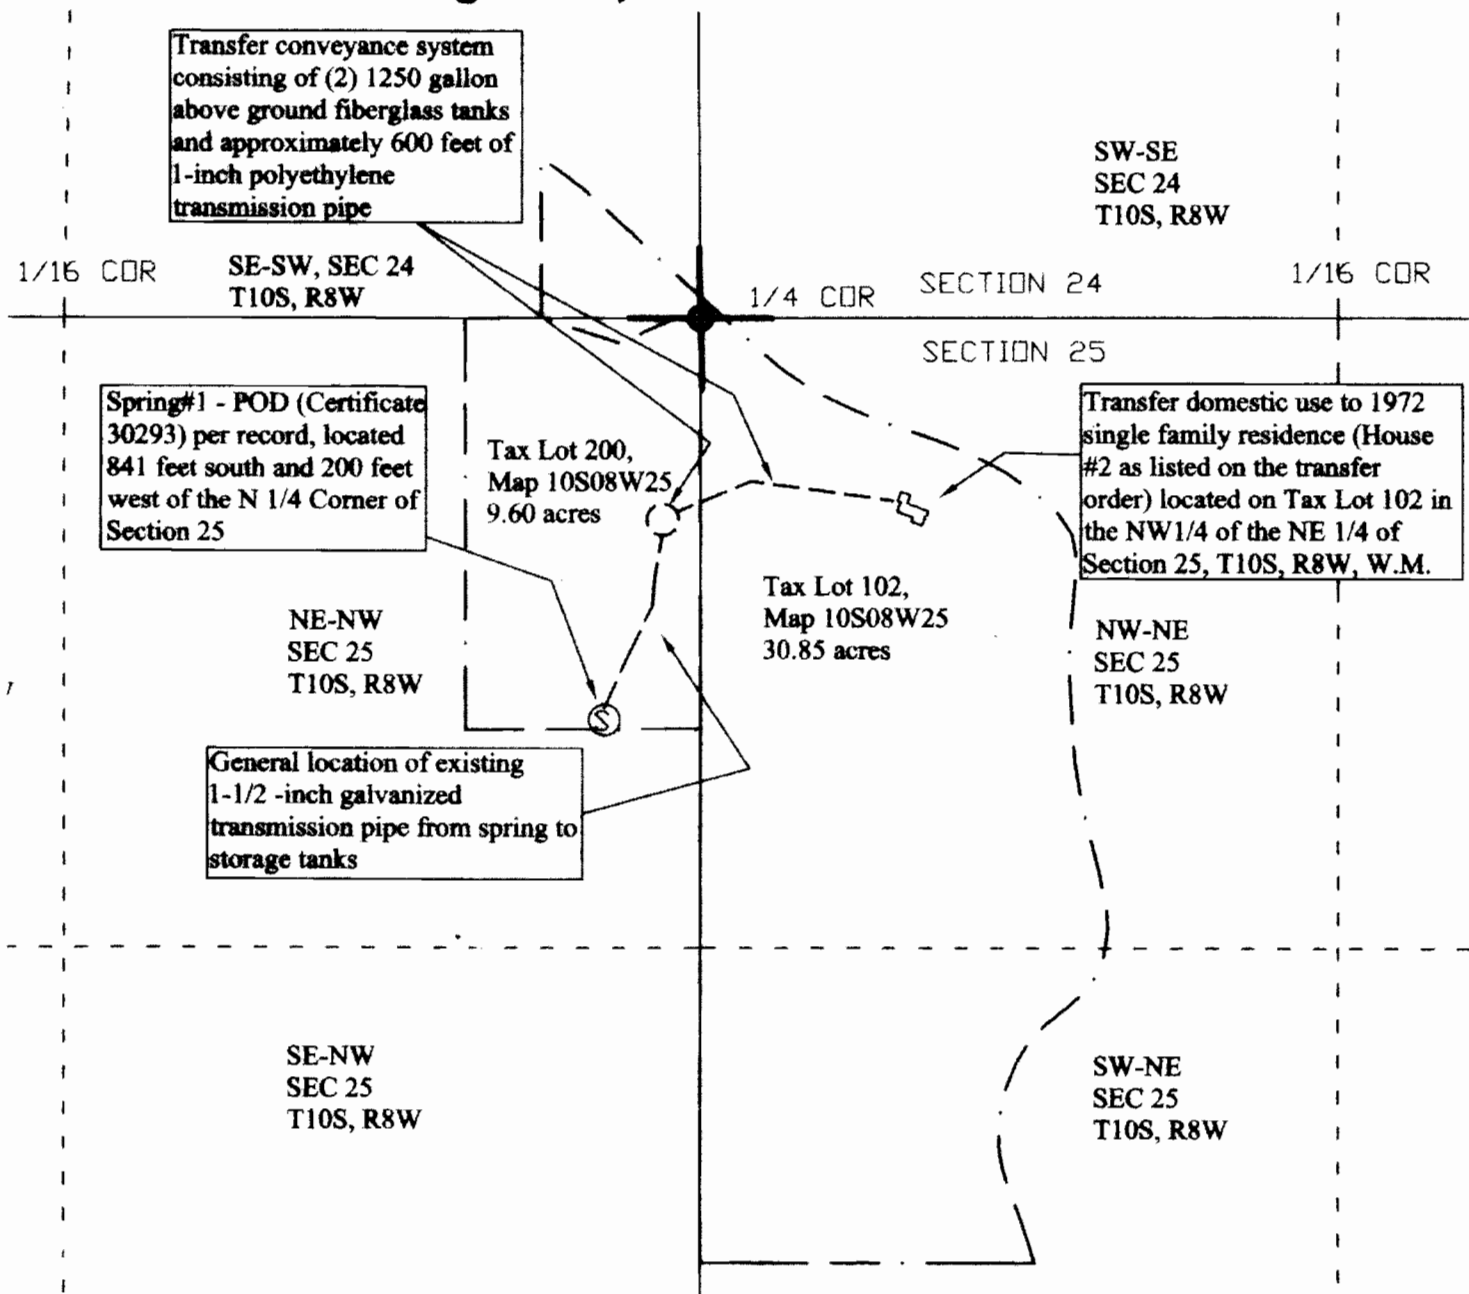

RENEWAL DATE: 12/31/2012

LEGEND

- QTR SECTION LINES
- - - - - QTR-QTR LINES
- . - . - PROPERTY LINES
- - - - - 1" DIA. WATER LINE

HOUSE POSITION RELATIVE TO 1/4 CORNER
 BASED ON CONVENTIONAL SURVEY