


Township 23 South, Range 10 West,
Willamette Meridian, Douglas County, Oregon

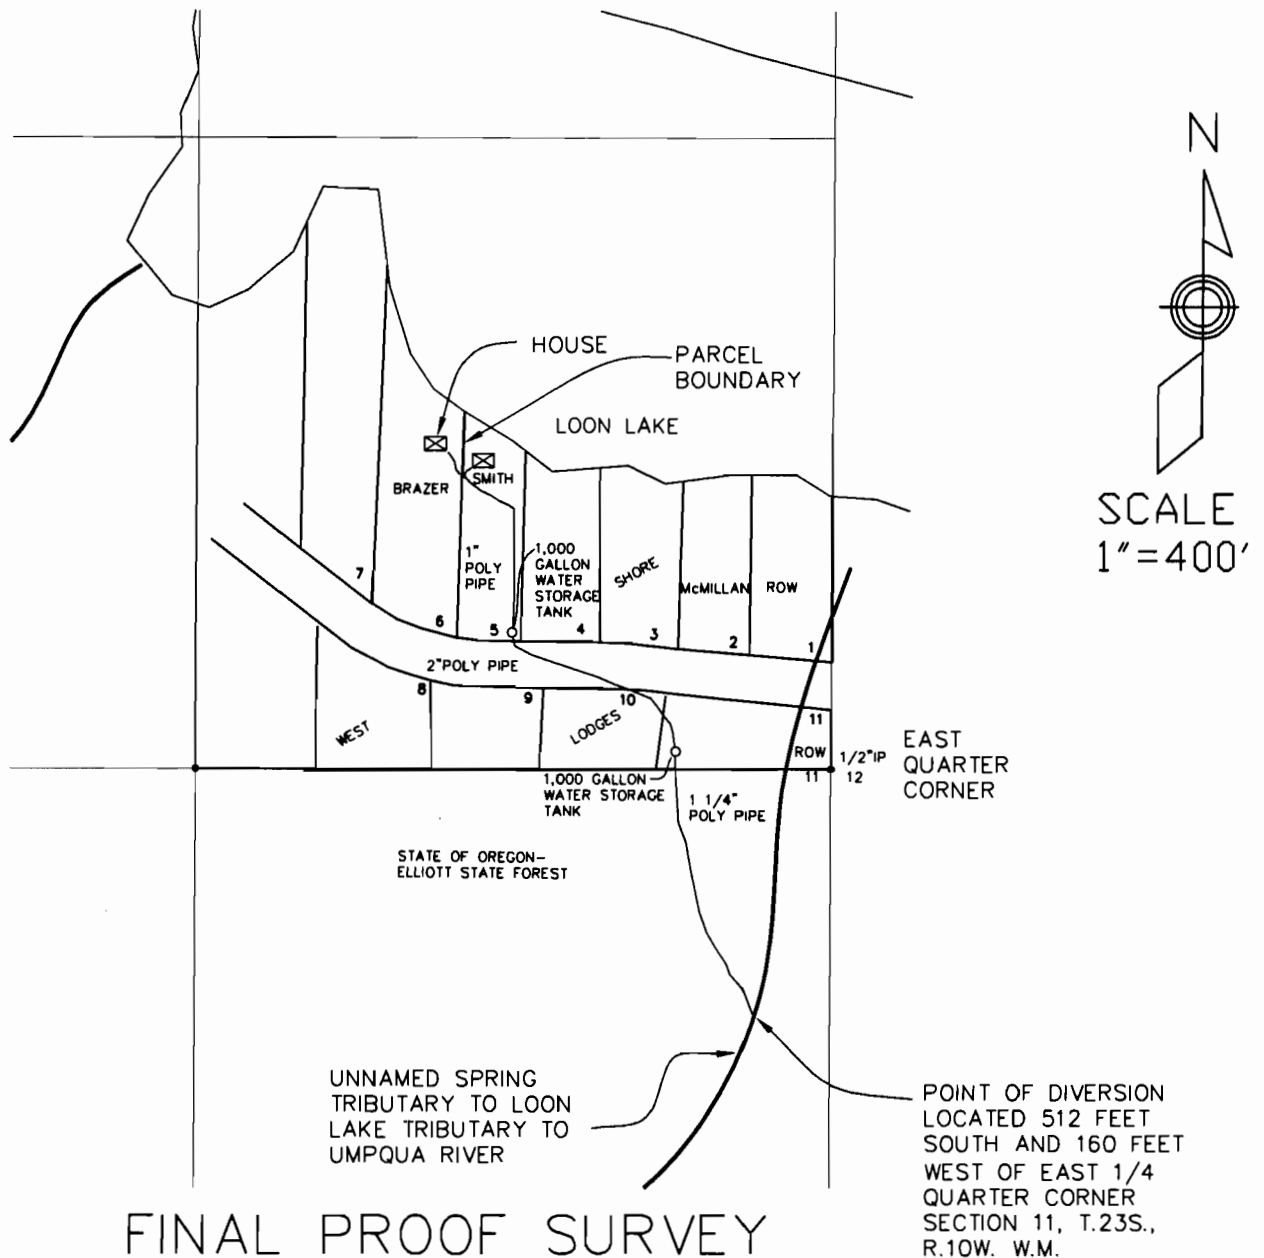

FINAL PROOF SURVEY

under
Application Number 56903, Permit Number 42742
Transfer Number T-8052

JANUARY 10, 2003



RECEIVED

APR 22 2003

WATER RESOURCES DEPT
SALEM, OREGON

FOR: JOHN & JANET BRAZER
P.O. BOX 237
COQUILLE, OR 97423

GREGORY W. SMITH
& ~~775 EAST 22ND~~ *4340 Spring Blvd.*
EUGENE, OR 97405

BY: KELLY LAUREN MERRITT, PE, CWRE
P.O. BOX 37
LAKESIDE, OR 97449

THIS MAP WAS PREPARED FOR THE PURPOSE
OF IDENTIFYING THE LOCATION OF A WATER
RIGHT ONLY AND IS NOT INTENDED TO
PROVIDE LEGAL DIMENSIONS OR LOCATION OF
PROPERTY OWNERSHIP LINES.