


T.33S.,R.2E.,W.M.
 Jackson County, Oregon
 TAX LOT No. 332E 11 - 2708
 ROGUE BASIN

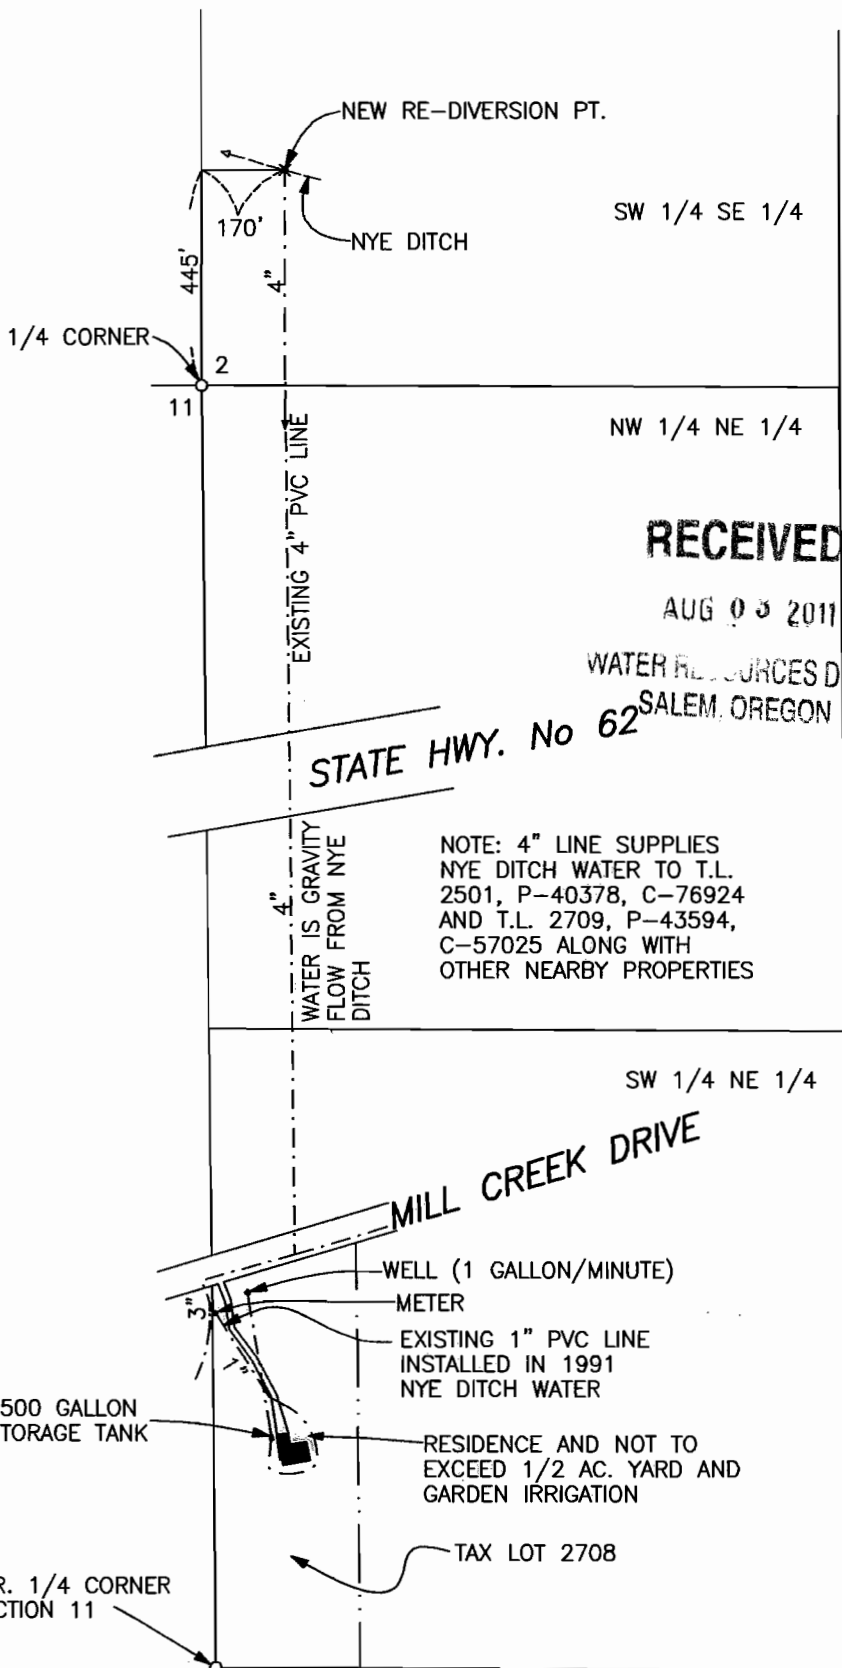

SCALE 1" = 400'



CLAIM OF BENEFICIAL USE MAP

APPLICATION No. T-10930

FOR:


A. WAYNE VOS AND
 TENA VOS
 1863 MILL CREEK DRIVE
 PROSPECT, OR. 97536

PREPARED BY:

GARY D. KAISER
 19440 HWY. 62
 EAGLE POINT, OR. 97524

July 27, 2011

NOTE: MAP PREPARED FOR
 WATER RIGHT PURPOSES ONLY,
 NOT FOR PROPERTY BOUNDARY
 LOCATIONS.

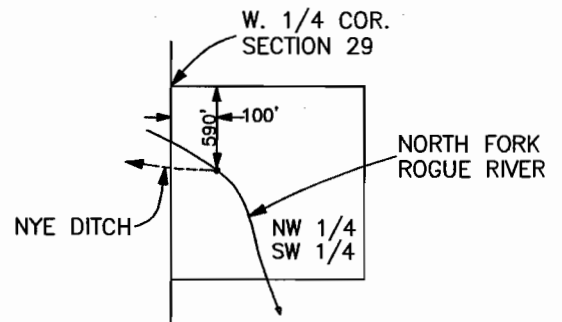

NYE DITCH DIVERSION POINT
 T.32S.,R.3E.,W.M.
 SCALE 1" = 1320'

