


CLAIM OF BENEFICIAL USE  
 FOR: PETER E. GRIFFIN & DIANE W. GRIFFIN  
 BY: DUANE W. KIRBY  
 T 26S, R5W W. M.  
 SECTION 16  
 TRANSFER NO 9993  
 FISH SCREEN IS AT THE DIVERSION POINT  
 TAX LOT 600

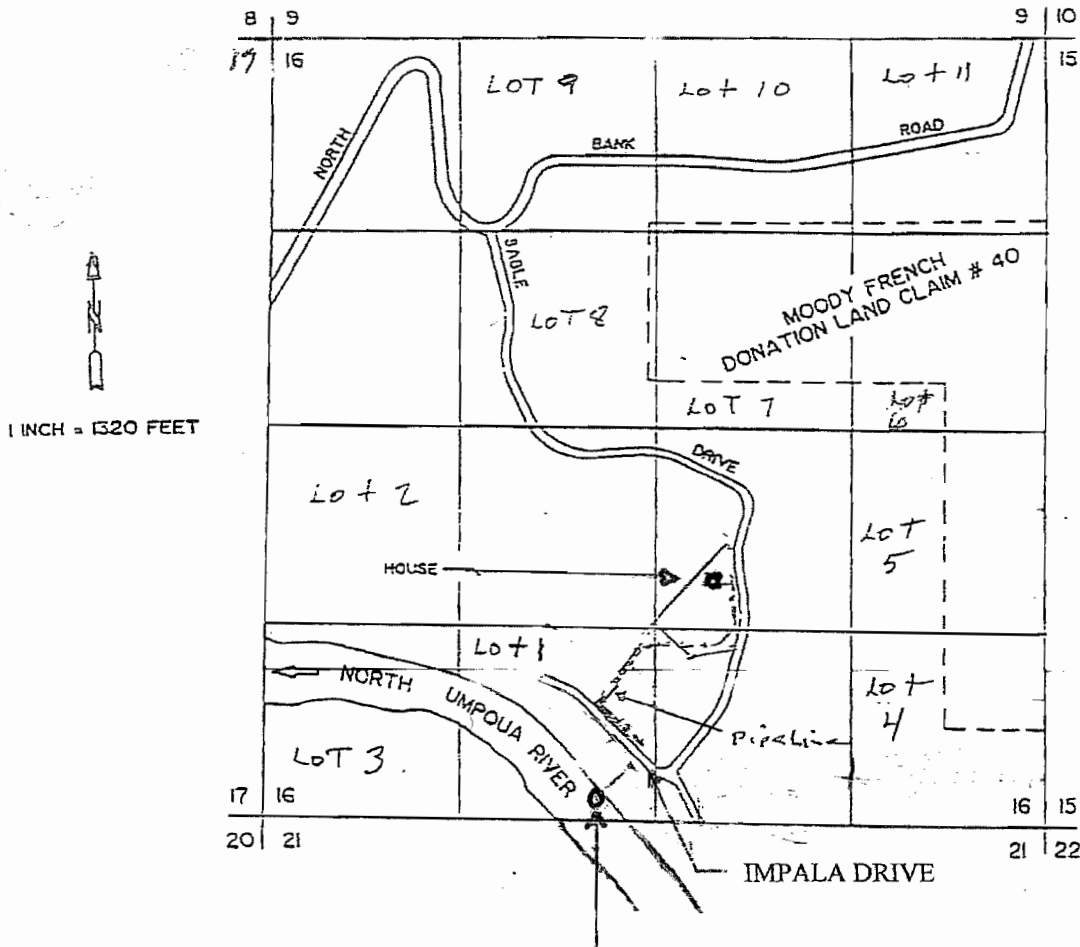

POD IS LOCATED 200 FT. N AND 380 FT. W. FROM THE S  $\frac{1}{4}$  CORNER OF SECTION 16

THE PURPOSE OF THIS MAP IS TO IDENTIFY THE LOCATION OF THE WATER RIGHT. IT IS NOT INTENDED TO PROVIDE INFORMATION RELATIVE TO THE LOCATION OF PROPERTY OWNERSHIP BOUNDARY LINES.



RECEIVED 2007