

T.33S.,R.2E.,W.M.





SCALE 1" = 400'

RECEIVED

OCT 29 2003

WATER RESOURCES DEP.
SALEM, OREGON

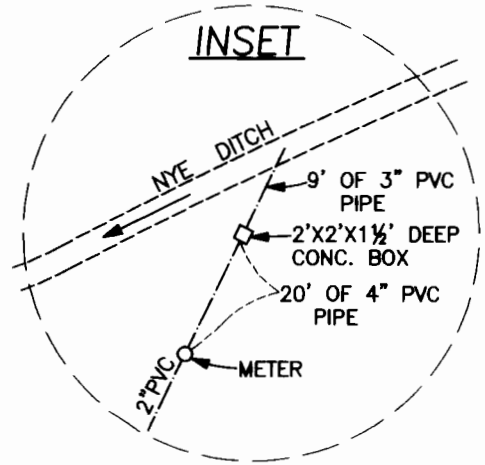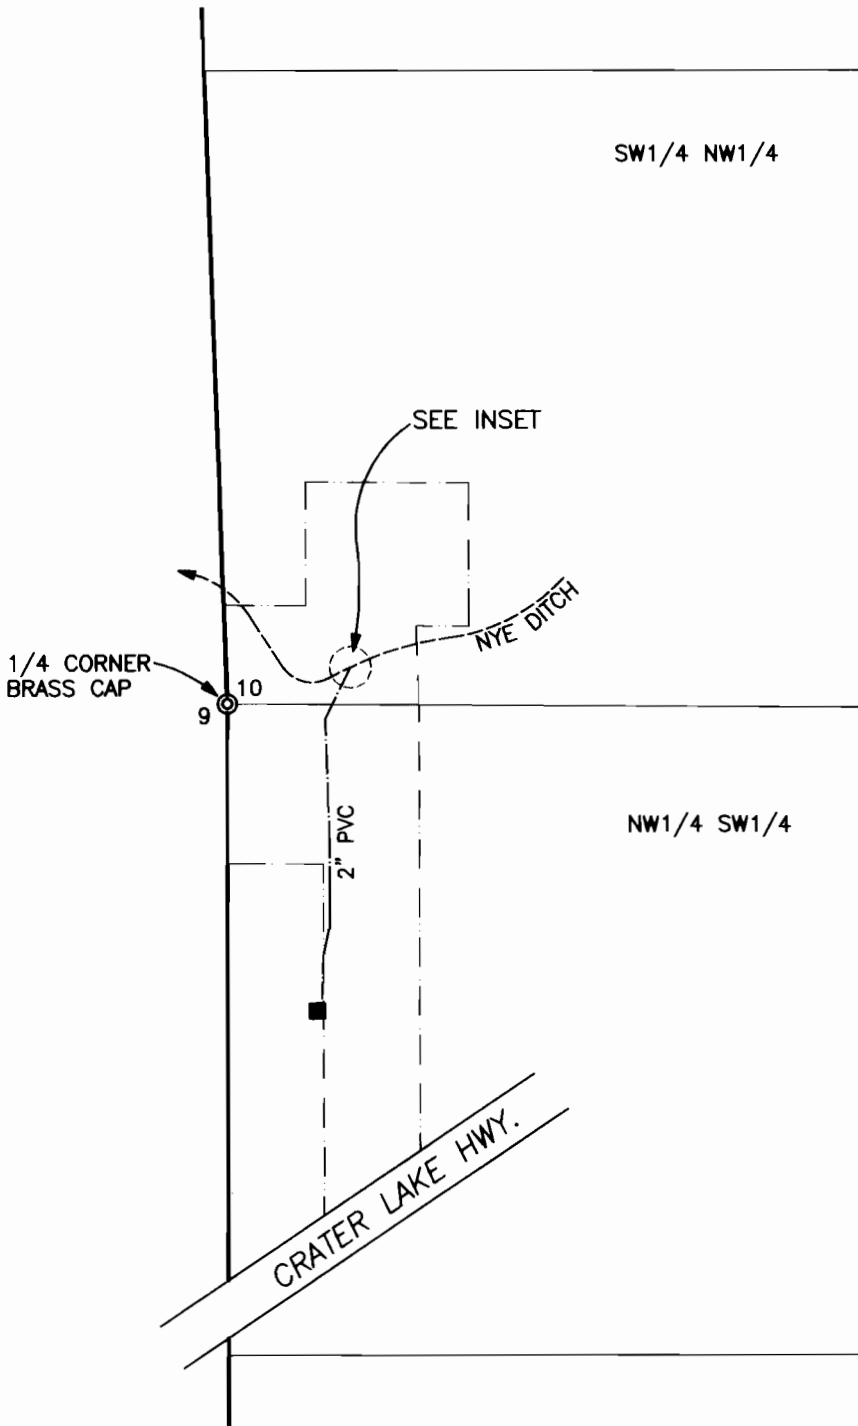


NOTE: MAP PREPARED FOR WATER RIGHT PURPOSES ONLY, NOT FOR PROPERTY BOUNDARY LOCATIONS.

CLAIM OF BENEFICIAL USE MAP
APPLICATION No. T-8780

IN THE NAME OF
RONALD & MELODY BEAN

MAP PREPARED SEPTEMBER 29, 2003 BY GARY D. KAISER

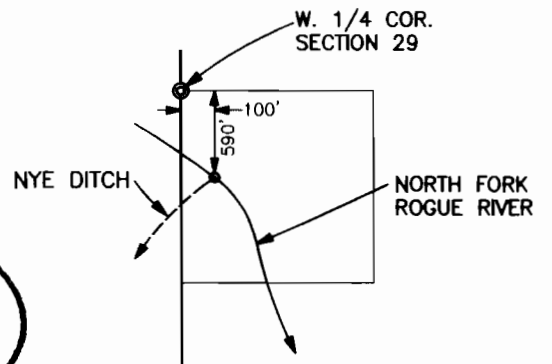

NYE DITCH DIVERSION POINT
T.32S.,R.3E.,W.M.
SCALE 1" = 1320'