


Claim of Beneficial Use Map for SHOTGUN RANCH, LLC

Pond #2
App R-86752
Per R-14419

Pond #3
App R-86754
Per R-14421


Pond #5
App R-86756
Per R-14423

T. 17S., R. 20 E., W. M.

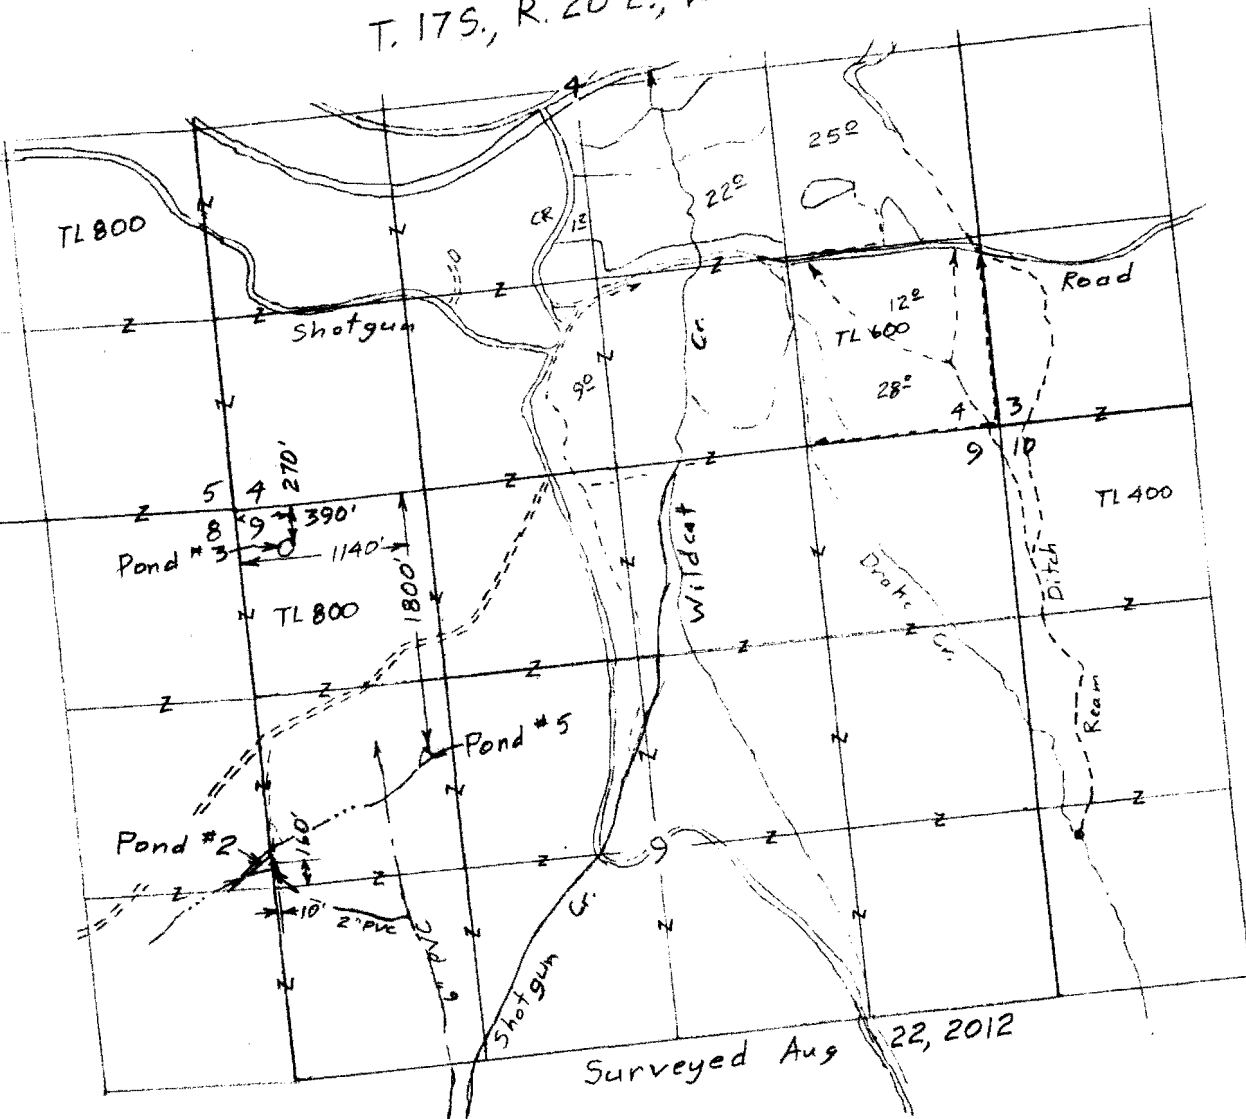

Scale 1"=1320'
(4"=1 mile)

Surveyed Aug 22, 2012

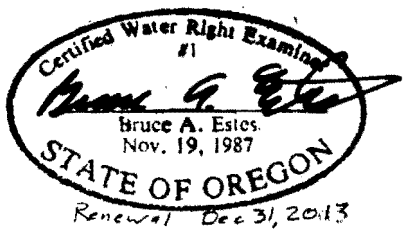

This map is for the purpose of locating a water right only and has no intent to provide legal dimensions or the location of property lines.

ESTES SURVEYS, LLC
 PO Box 17519
 Salem, OR 97305-7519
 (503) 565-7599
 60382 Arnold Rd
 Bend, OR 97702
 (541) 382-7391