


T. 17 S., R. 20 E., W. M.

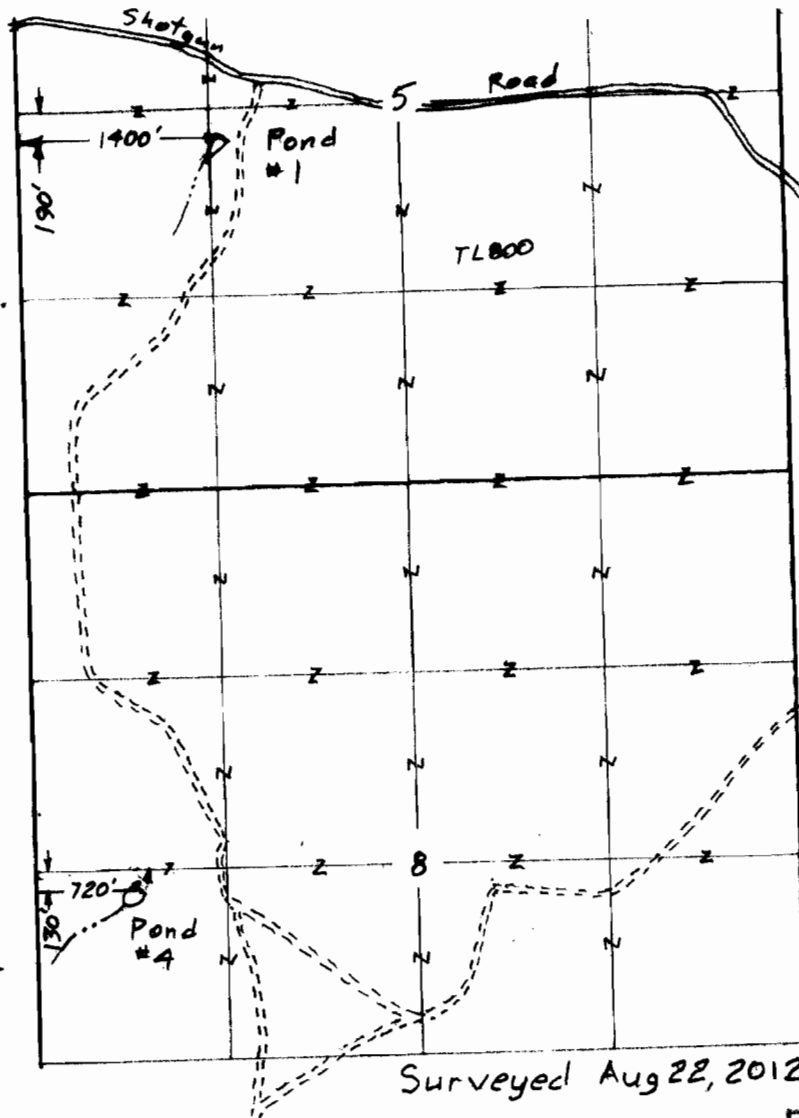

Scale 1" = 1320'  
(4" = 1 mile)


Ponds #1 & #4  
 #1 App R-86753  
 Per R-14420  
 #4 App R-86755  
 Per R-14422

RECEIVED BY OWRD

MAR 29 2013

SALEM, OR

Claim of Beneficial Use Map  
 for  
 SHOTGUN RANCH, LLC

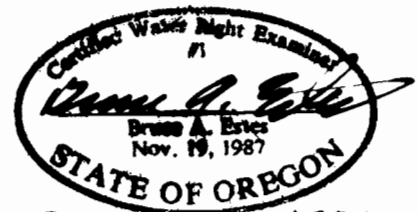

This map is for the purpose of  
 locating a water right only  
 and has no intent to provide  
 legal dimensions or the location  
 of property lines.

**ESTES SURVEYS, LLC**  
 PO Box 17510  
 Salem, OR 97305-7510  
 (503) 566-7300  
 60382 Arnold Rd  
 Bend, OR 97702  
 (541) 382-7391