

Claim of Beneficial Use Map for SHOTGUN RANCH, LLC

Pond #2
App R-86752
Per R-14419


Pond #3
App R-86754
Per R-14421

Pond #5
App R-86756
Per R-14423


T. 17S., R. 20 E., W. M.



Scale 1" = 1320'
(4" = 1 mile)

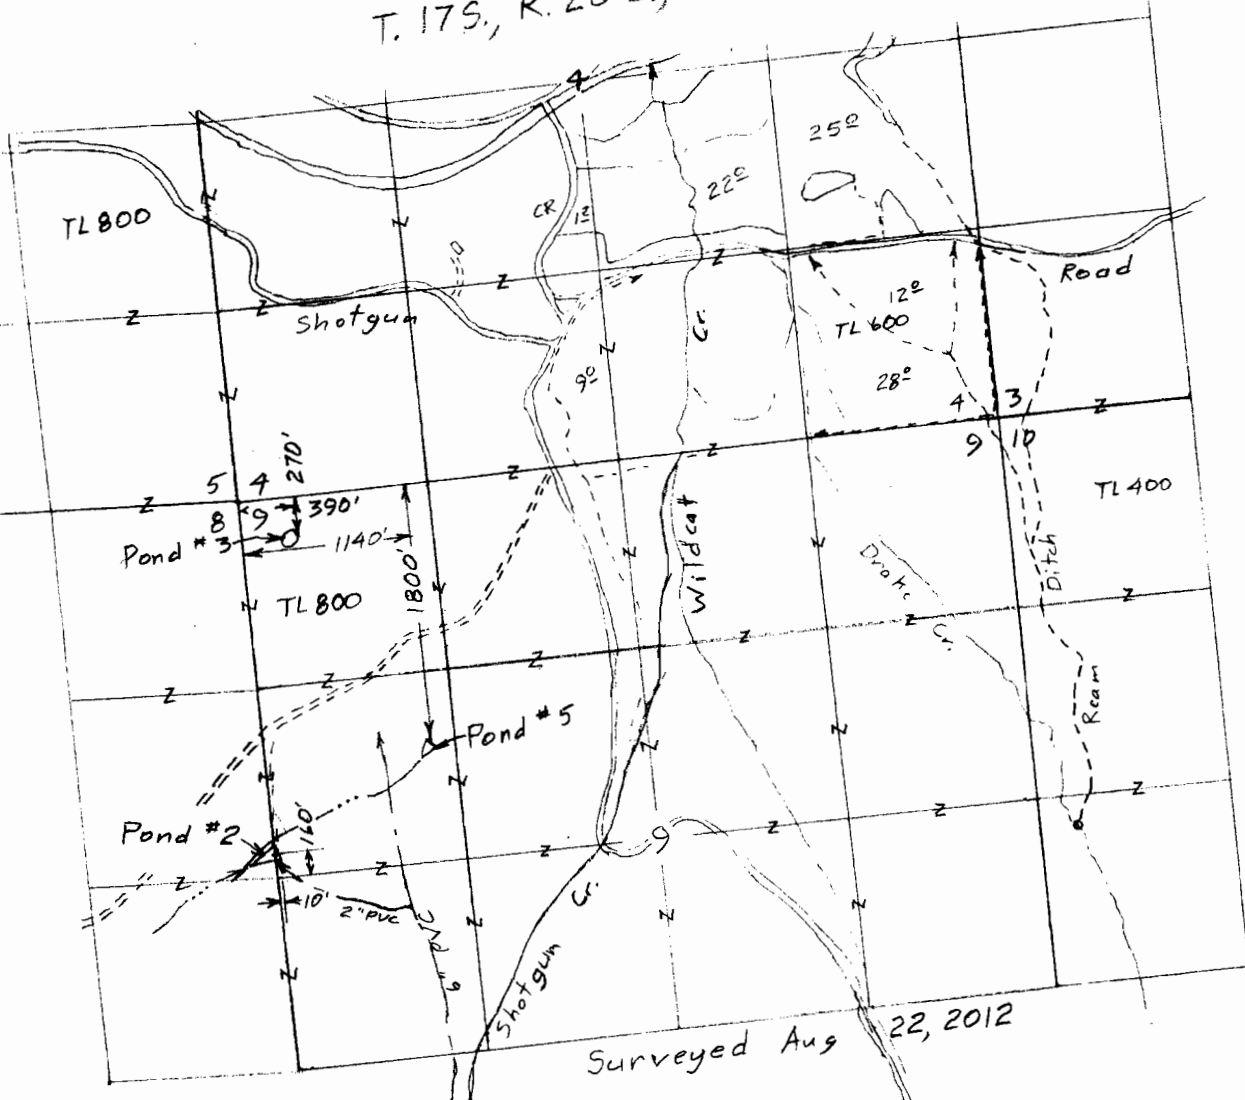

Surveyed Aug 22, 2012

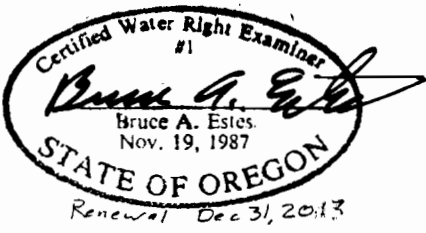

This map is for the purpose of locating a water right only and has no intent to provide legal dimensions or the location of property lines.

ESTES SURVEYS, LLC

<p>PO Box 17519 Galeton, OR 97005-7519 (503) 365-7596</p>	<p>60382 Arnold Rd Bend, OR 97702 (541) 382-7391</p>
--	--