

28 27
33 34


RECEIVED

SEP 30 2009


WATER RESOURCES DEPT
SALEM, OREGON

Claim of Beneficial Use

T-10185
Graves Family Revocable Trust

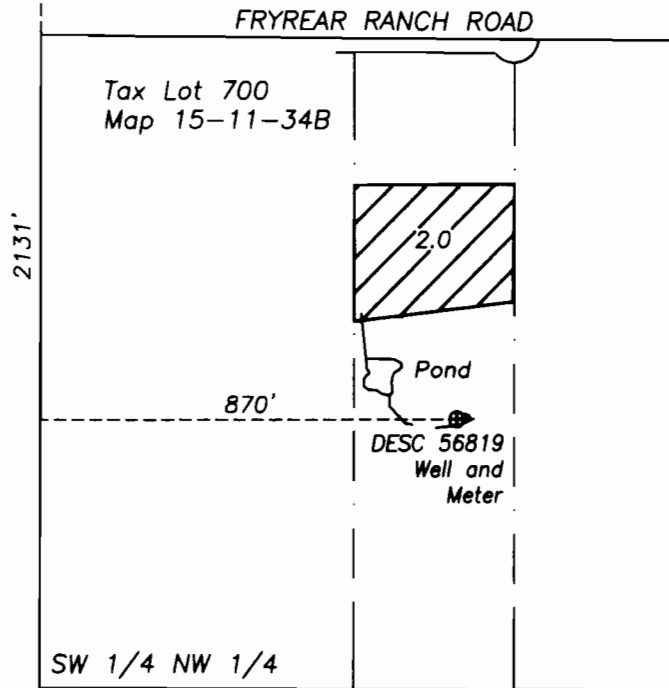

Section 34
T15S, R11E, W.M.
Deschutes Co., OR

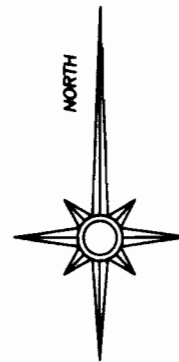

Renewal date: 6/30/2010

Legend



Water beneficially applied under transfer
T-10185, priority date 8/31/1992.

— — — — — Property line

— — — — — Mainline

400 0 400 800 1200



GRAPHIC SCALE - FEET

THIS MAP IS FOR THE PURPOSE OF IDENTIFYING THE LOCATION OF THE WATER RIGHT. IT IS NOT INTENDED TO PROVIDE LEGAL DIMENSIONS OR LOCATIONS OF PROPERTY OWNERSHIP LINES.