

CLAIM OF BENEFICIAL USE FINAL PROOF MAP  
 Located in SW¼ SE¼ & SE¼ SE¼ of Section 32,  
 Township 29 South, Range 12 West, W.M.

Coos County, Oregon

TRANSFER 7394

Prepared For: David W. Herman


Prepared By: Dennis Goude

Date Prepared: May 5, 2004

Scale 1"=400'

NOTE:

THE POINT OF DIVERSION (P.O.D. CERTIFICATE 34441)  
 IS LOCATED 840 FEET SOUTH AND 750 FEET EAST  
 FROM THE SOUTH ¼ CORNER OF SECTION 32.  
 P.O.D. (TRANSFER 7394) IS LOCATED 410 FEET  
 NORTH AND 570 FEET EAST FROM THE S ¼.

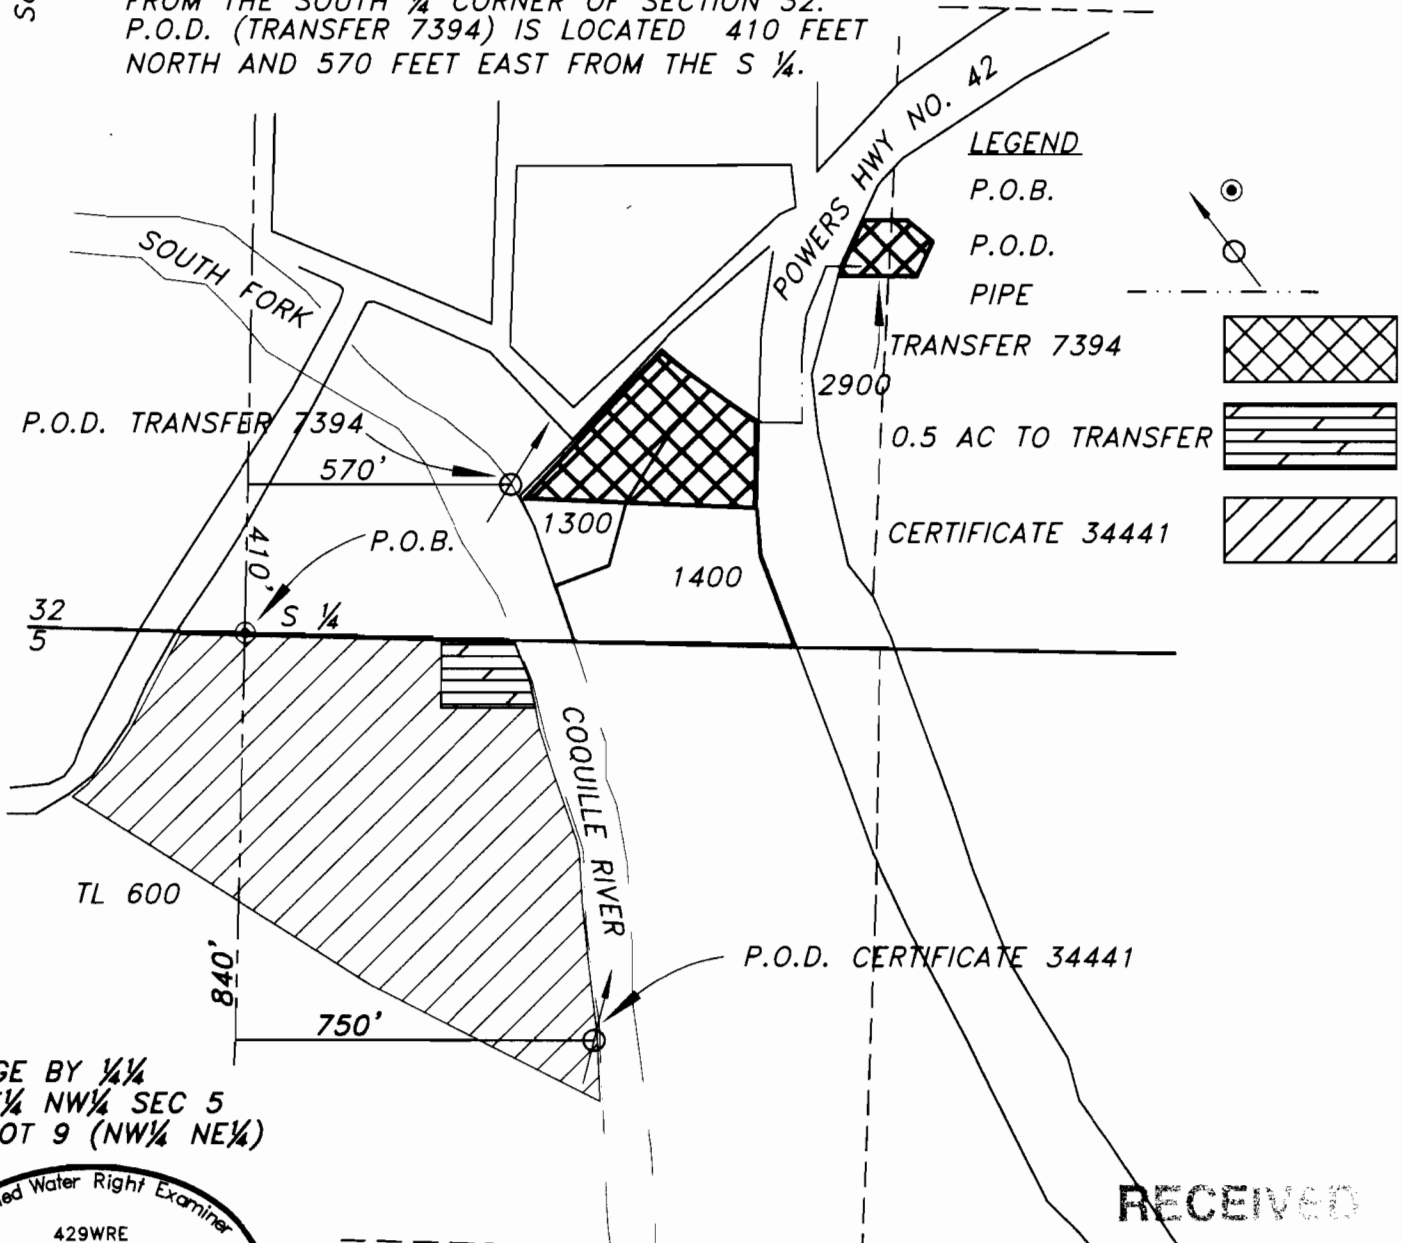

LEGEND

P.O.B.

P.O.D.


PIPE

TRANSFER 7394

0.5 AC TO TRANSFER

CERTIFICATE 34441

ACREAGE BY ¼¼  
 3.3 NE¼ NW¼ SEC 5  
 13.8 LOT 9 (NW¼ NE¼)

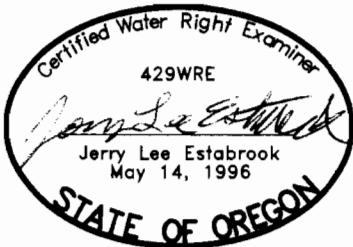

EXPIRES 12/31/2005

EXAMINERS DISCLAIMER STATEMENT

The preparation of this map was for the purpose of identifying the location of the Water Right only and has no intent to provide dimensions or location of property ownership lines.

RECEIVED

MAY 10 2004

WATER RESOURCES DIVISION  
 SALEM, OREGON

Stuntzner Engineering  
 & Forestry, L.L.C.

ENGINEERING • LAND SURVEYING • FORESTRY  
 PLANNING • WATER RIGHTS

705 South 4th St.  
 Post Office Box 118  
 Coos Bay, Oregon 97420

Phone: (541) 267-2872  
 Fax: (541) 267-0588