


RECEIVED

JUL 30 1999

WATER RESOURCES DEPT  
SALEM, OREGON

**FINAL PROOF MAP**  
**SURFACE WATER RIGHT**  
**TRANSFER NO. 7052**

LOCATED IN THE SE 1/4 OF THE NW 1/4 AND THE SW OF THE NE 1/4  
OF SECTION 33, T. 40 S., R. 13 W., CURRY COUNTY, OREGON

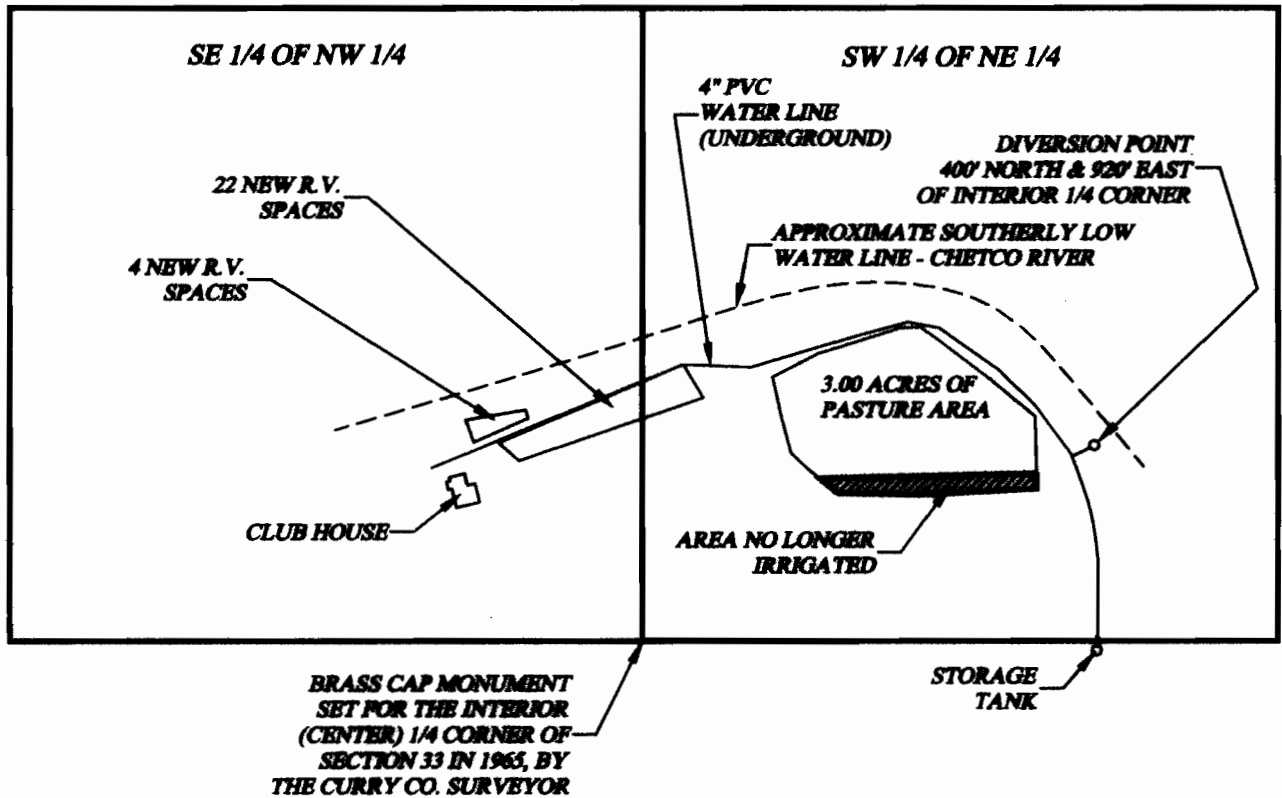

THIS MAP IS FOR THE PURPOSE OF IDENTIFYING  
THE LOCATION OF THE WATER RIGHT ONLY AND  
IS NOT INTENDED TO PROVIDE LEGAL DIMENSIONS  
OR LOCATIONS OF PROPERTY OWNERSHIP LINES.



Scale: 1" = 400'



EXPIRES: JUNE 30, 2000

**Reily Smith**  
**Land Surveying**  
P. O. Box 7276 Brookings, OR. 97415  
Ph: (541) 469-2826 Fax: (541) 469-7507

Job # 99-45	Applicant: <b>River Bend Corporation</b> P. O. Box 6788 Brookings, OR. 97415
Date: Aug. 2, 1999	
Drawn: R. H. Smith	
File: LAWH20.dwg	