


CLAIM OF BENEFICIAL USE
ALTERNATE REVIEW RESERVOIR
APPLICATION R-87476 PERMIT R-14841
TOWNSHIP 35 SOUTH RANGE 4 WEST, W.M.
JACKSON COUNTY OREGON

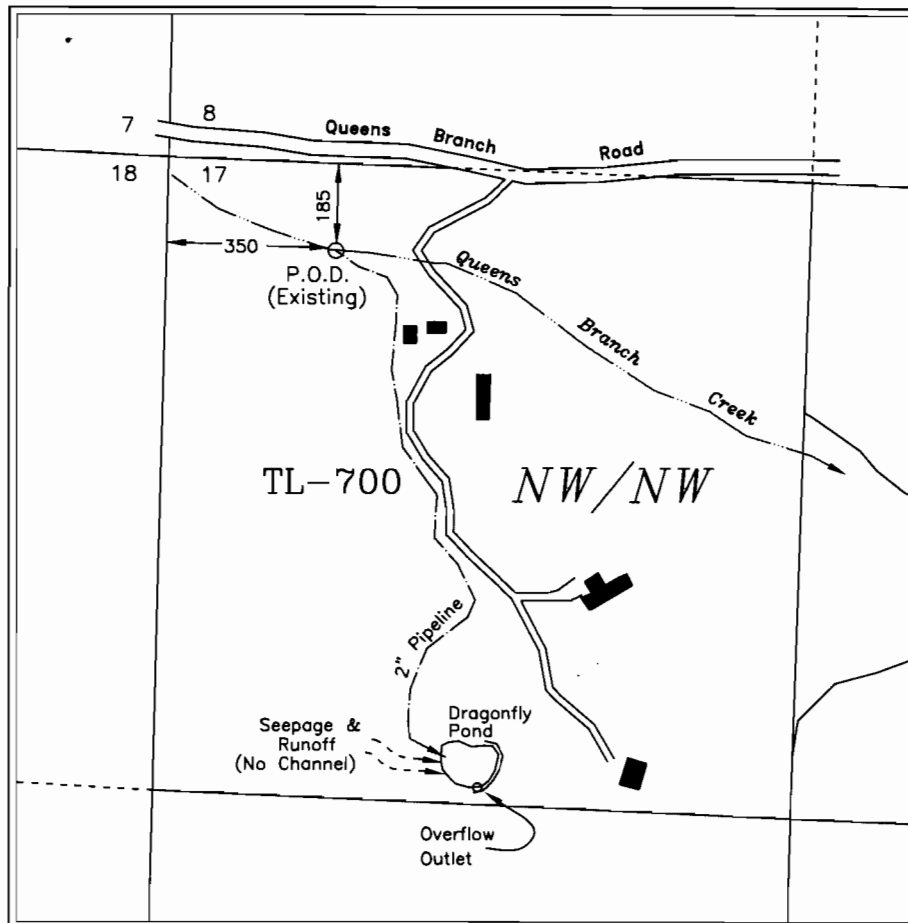

RECEIVED

JAN 31 2011

POINT OF DIVERSION: NW/NW Section 17, 185 feet south & 350 feet east from the NW corner section 17, T35S, R4W, W.M. **WATER RESOURCES DEPT
SALEM, OREGON**

CENTER OF POND: NW/NW Section 17, 1245 feet south & 660 feet east from the NW corner section 17, T35S, R4W, W.M.

Dragonfly Pond

Volume: 1.0 Acre-Foot

MULTI-PURPOSE USE

TERRY D. AND TAMARA K. SHORES
2585 Queens Branch Road
Rogue River, OR 97537

