

CLAIM OF BENEFICIAL USE
FOR: JEFF C. AND VIBEKE LAUGHLIN
BY DUANE W. KIRBY

T28S, R5W, WM, SECTION 22&23


T-10650

TAX LOT 401

NO FISH SCREEN REQUIRED

METER IS LOCATED 30' E OF HOUSE

COUNTY RD NO 16

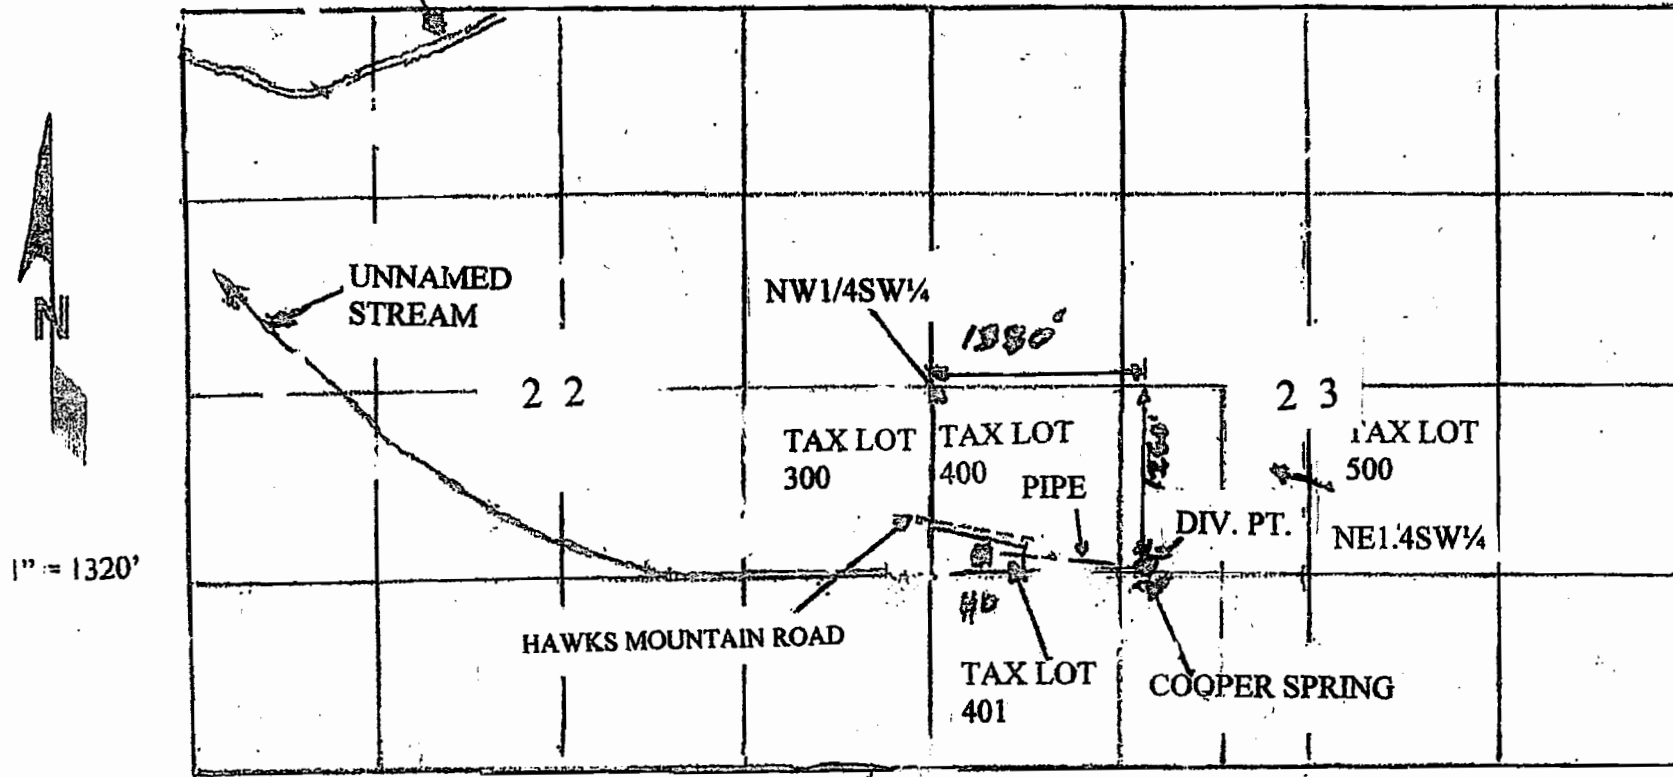

DIV. PT. IS LOCATED 1260' SOUTH AND 1380' EAST OF THE WEST COR. SEC
23

This map is not intended to provide
legal dimensions or locations of property lines

