


CLAIM OF BENEFICIAL USE
 FOR: BOB ALDRICH
 TRANSFER NO. 9561
 FISH SCREEN AT POINT OF DIVERSION

DATE: 5/30/89
 BY: DWK

SECTION 32, TOWNSHIP 26 SOUTH, RANGE 6 WEST, W.M.

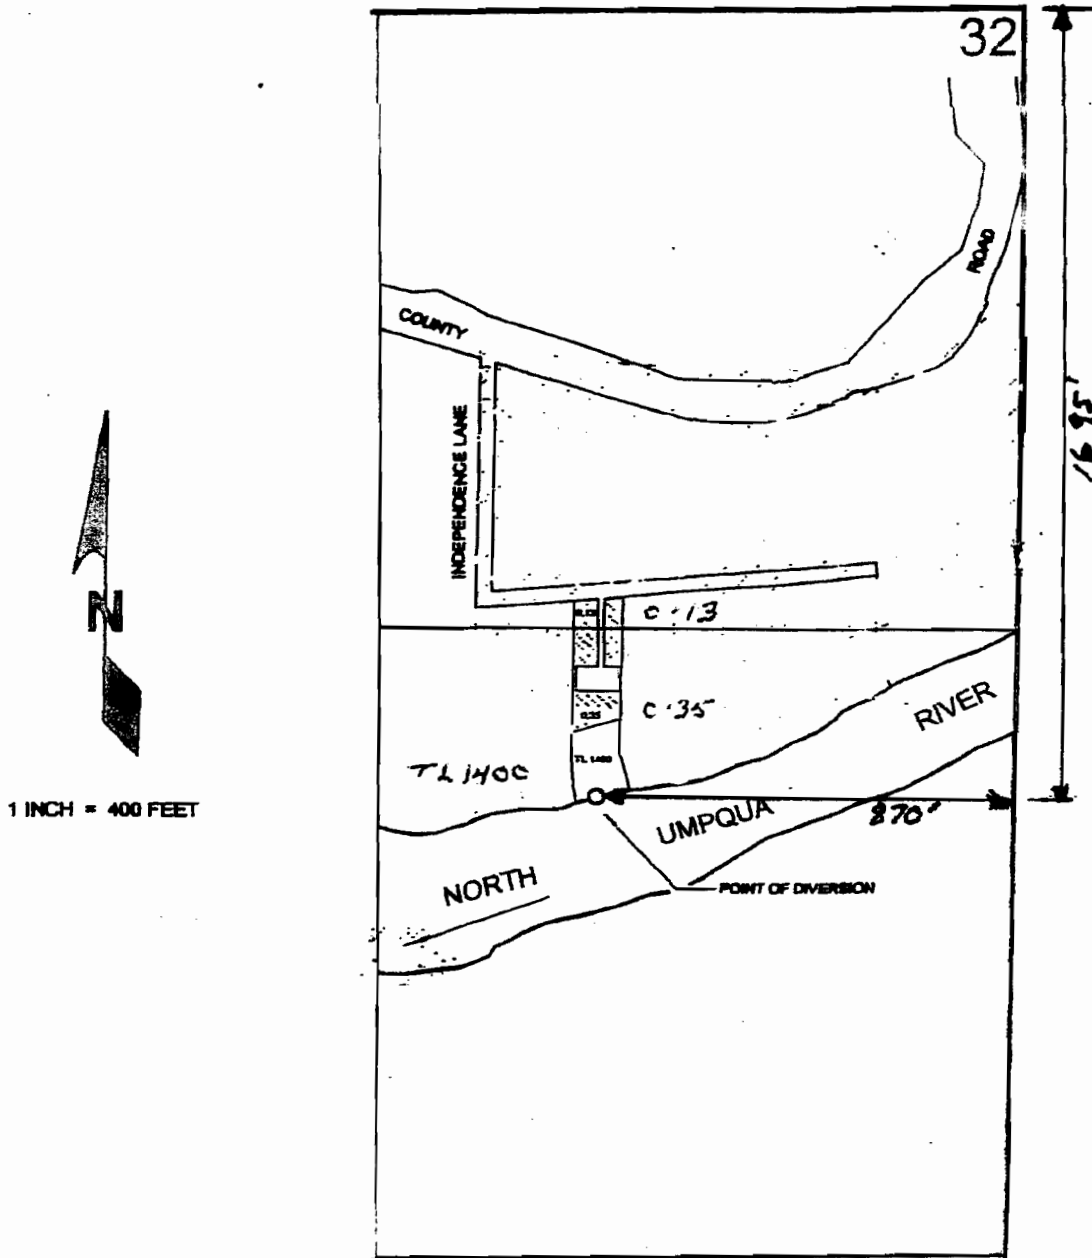

THE PURPOSE OF THIS MAP IS TO IDENTIFY THE LOCATION OF THE WATER RIGHT. IT IS NOT INTENDED TO PROVIDE INFORMATION RELATIVE TO THE LOCATION OF PROPERTY OWNERSHIP BOUNDARY LINES.

