


Claim of Beneficial Use: Point of Diversion Map Permit S-18654 (Application S-23660)

Water Right in the Name of City of Waldport
Township 13 South, Range 11 West (W.M.)

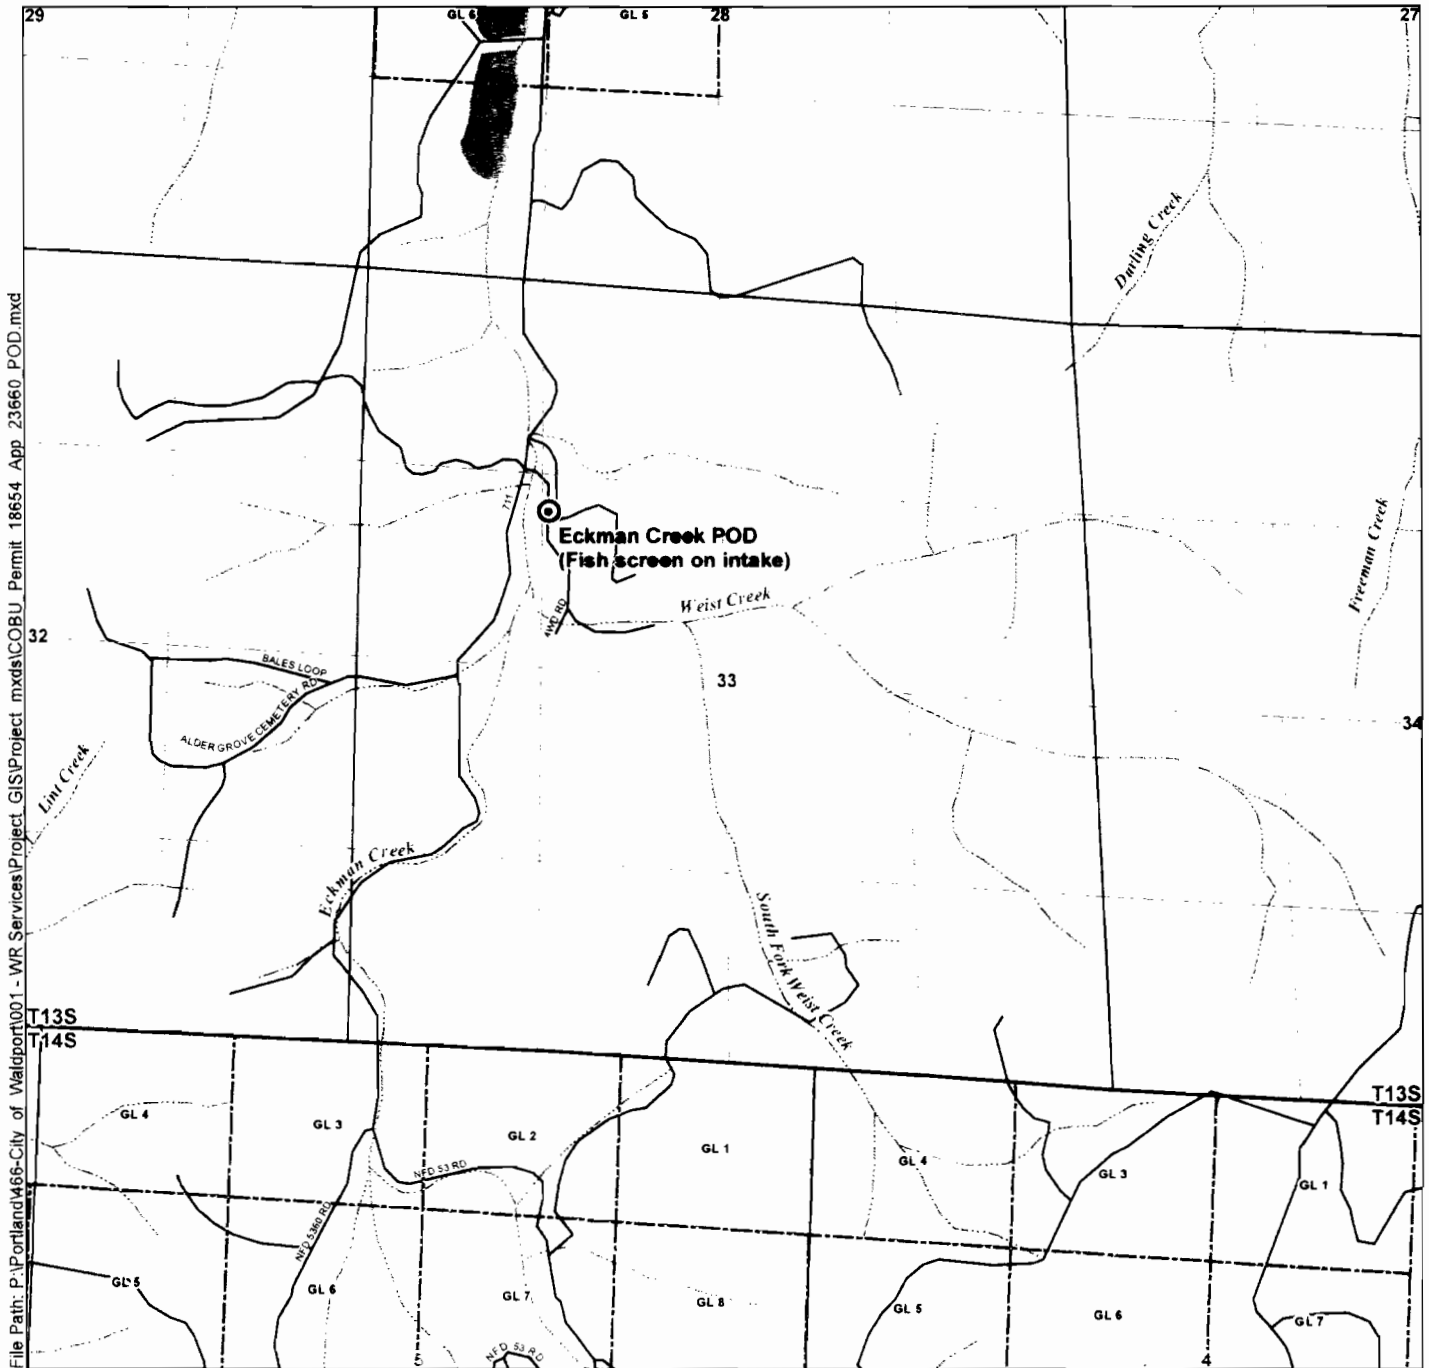


Legend

- Point of Diversion (POD)
- Government Lots
- Roads
- Watercourses
- Waterbodies

POD Location Description

Eckman Creek POD
North 47° 30' 22" West 1,693 feet from the C 1/4 corner of
Section 33, Township 13 South, Range 11 West, (W.M.)

Certified Water Rights Examiner Stamp

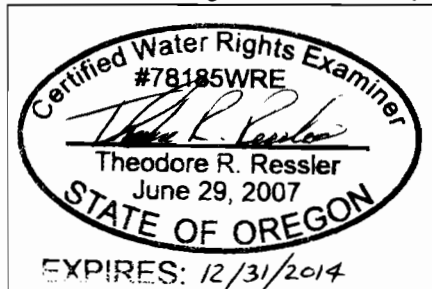


Disclaimer

This map was prepared for the purpose of identifying the location of a water right only and it is not intended to provide legal dimensions or location of property ownership lines.


Map Notes

Date: December 12, 2012
Data Sources: OGIC, US BLM
Prepared By: GSI Water Solutions, Inc.

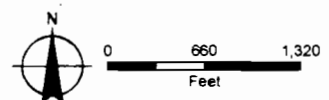

Claim of Beneficial Use: Place of Use Map Permit S-18654 (Application S-23660)

Water Right in the Name of City of Waldport
Township 13 South, Ranges 11 & 12 West (W.M.)

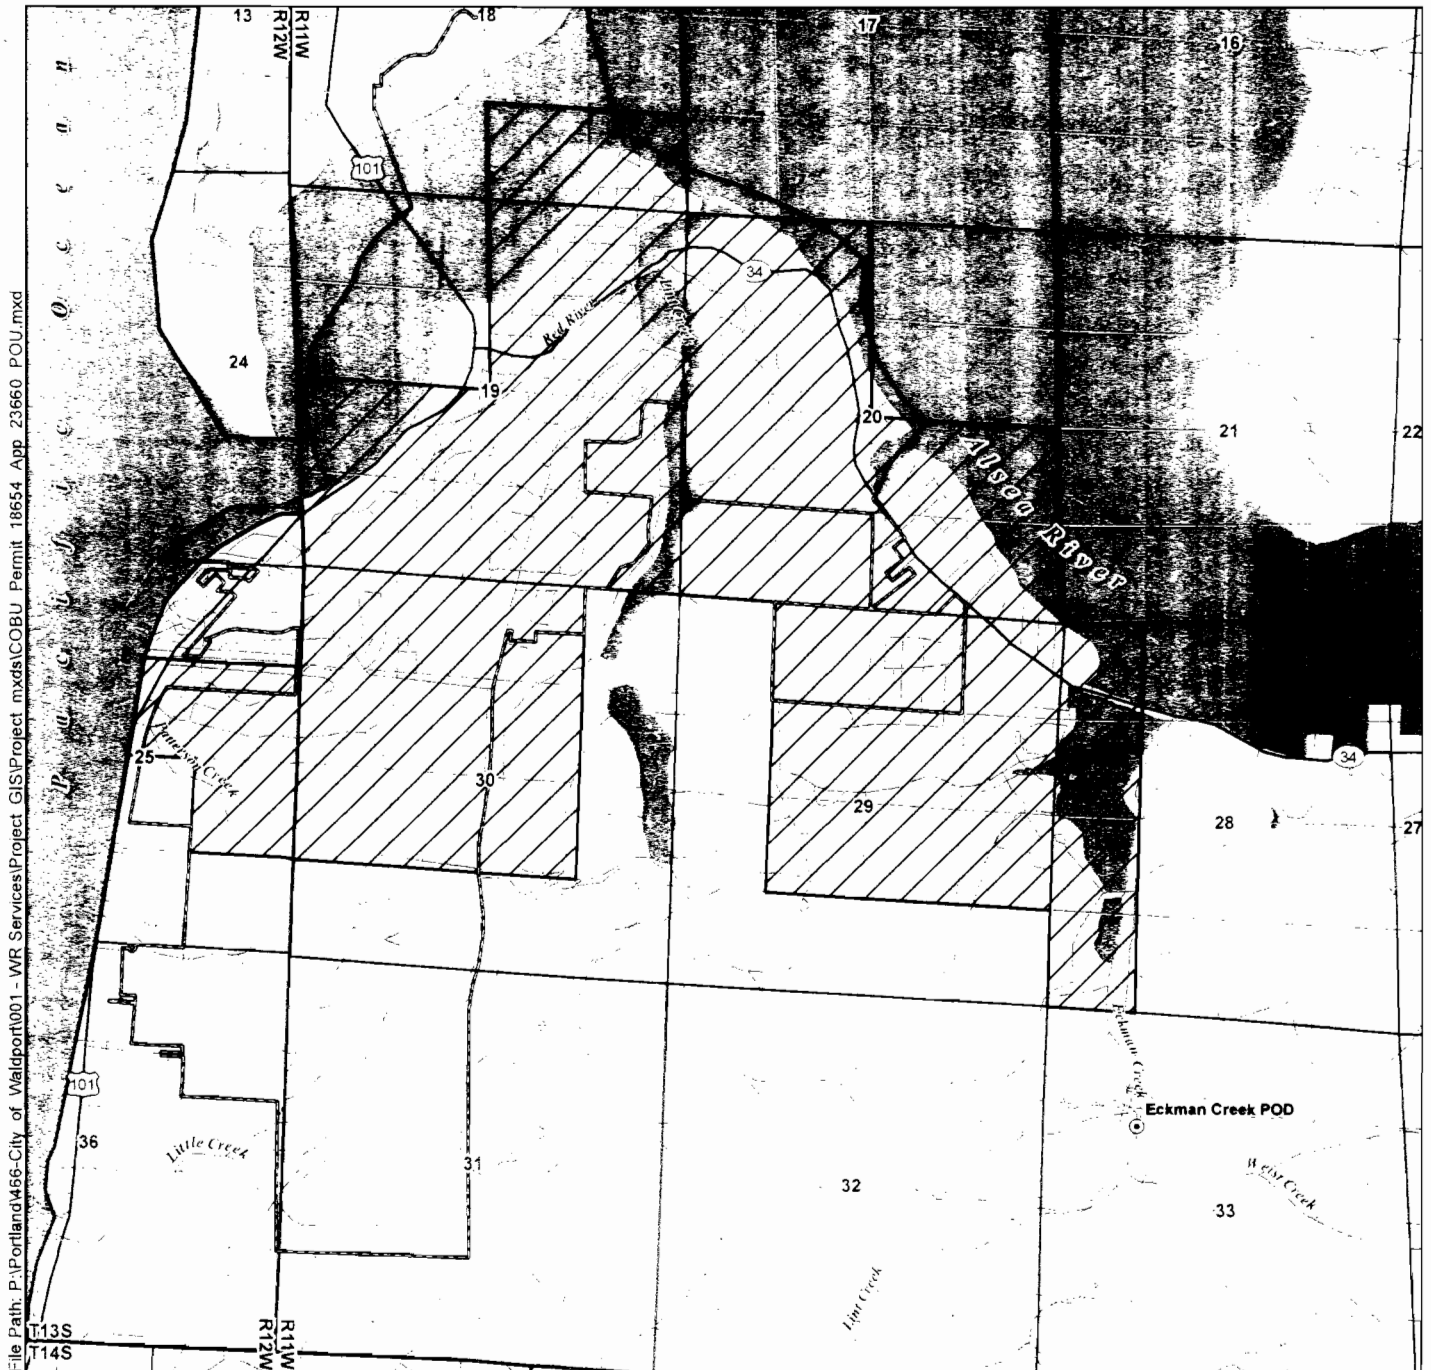


Legend

- Place of Use (POU)
- Point of Diversion (POD)
- Waldport City Limits
- Highways
- Roads
- Watercourses
- Waterbodies

POD Location Description

Eckman Creek POD
North 47° 30' 22" West 1,693 feet from the C 1/4 corner of
Section 33, Township 13 South, Range 11 West, (W.M.)

Certified Water Rights Examiner Stamp

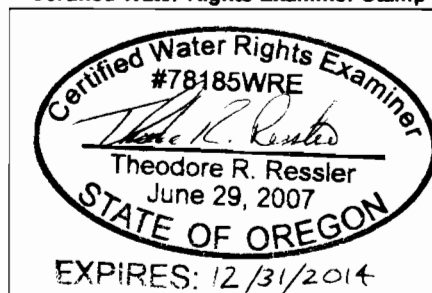

Disclaimer

This map was prepared for the purpose of identifying the location of a water right only and it is not intended to provide legal dimensions or location of property ownership lines.

Map Notes

Date: December 12, 2012
Data Sources: OGIC, US BLM
Prepared By: GSI Water Solutions, Inc.

