


# Claim of Beneficial Use


## Transfer T-10186

In the name of:  
Lawrence and Kathleen Lennon


T15S, R11E, W.M.  
28 27 Deschutes Co., OR

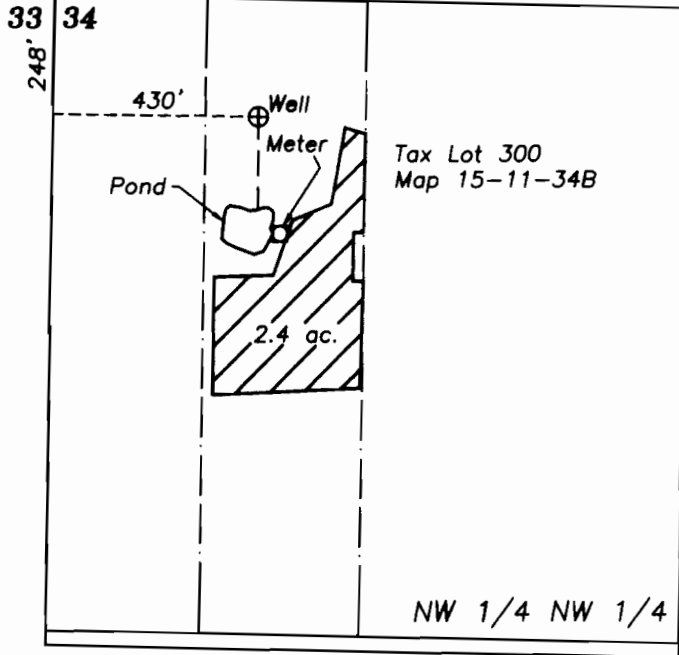

Fryrear Ranch Road

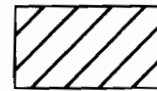


Area irrigated under  
Transfer T-10186, priority  
date 8/31/1992

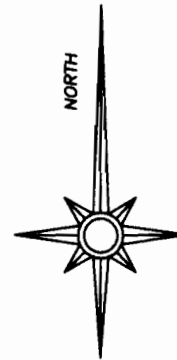

### Legend

- — — — — Property boundary
- - - - - Mainline to pond

SEP 29 2009

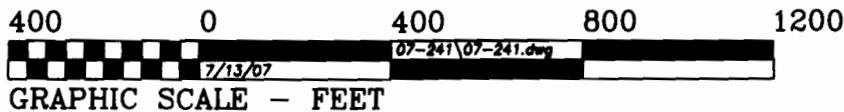

THIS MAP IS FOR THE PURPOSE OF IDENTIFYING THE LOCATION OF THE WATER RIGHT. IT IS NOT INTENDED TO PROVIDE LEGAL DIMENSIONS OR LOCATIONS OF PROPERTY OWNERSHIP LINES.