

CLAIM OF BENEFICIAL USE MAP

Jayme Kaczmarek
Fryrear Ranch Road
Bend, Oregon 97701

Permit No. G-12705
Application T-10184


TOWNSHIP 15 SOUTH, RANGE 11 EAST, W.M.
SECTION 33 SE NE



1" = 400'
SCALE


PLOTTED: 10 Nov 2008, 12:55pm, crogers

CAD FILE: U:\C\rogers\120008\00\Project\Kaczmarek\Water1 LAYOUT: Layout1

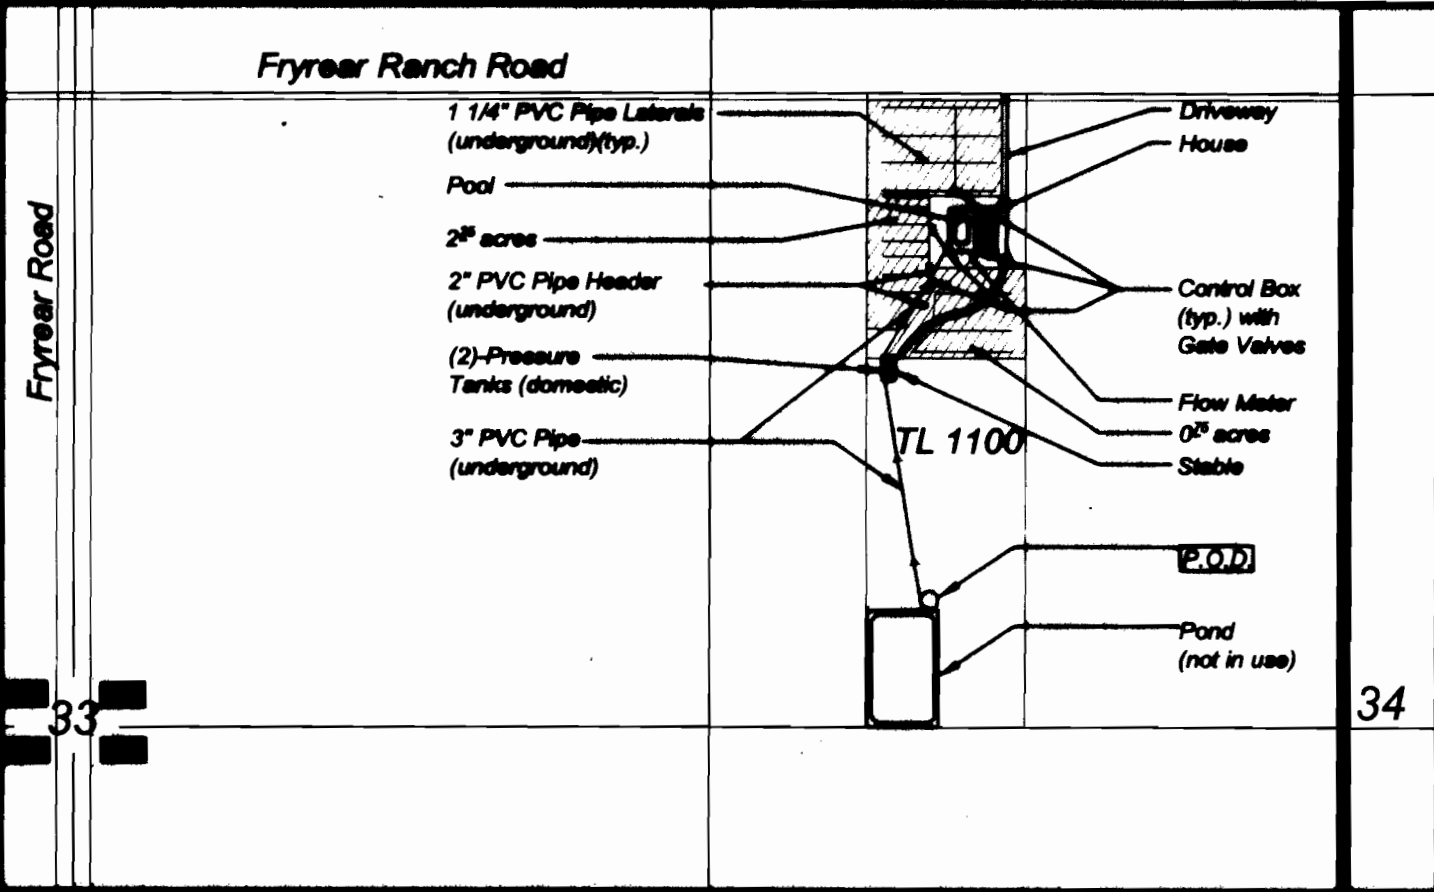

Water Application Area

POINT OF DIVERSION LOCATION:
2375' south & 880' west of the
NE corner of Section 33
Site Inspection - August 26, 2008

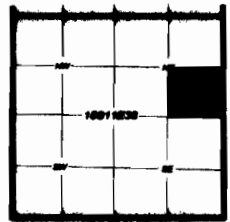

PLSS Locator Map

RECEIVED

JAN 02 2009

WATER RESOURCES DEPT
SALEM, OREGON

EXPIRATION DATE: 06/30/09

The information included on this graphic representation has been compiled from a variety of sources and is subject to change without notice. It shall not be used as a representation of ownership, easement or right, or as a warranty, completion, finalness, or rights to the use of such information. This document is not intended for use as a final survey product nor to be developed or recorded as a construction design document. The use or reliance of this information on this graphic representation is at the sole risk of the party using or relying on the information.

This map is for the purpose of locating a water right only and has no intent to provide legal dimensions or the location of property lines.

ATTACHED IMAGES: PowellButteGeo.bmp Images: rectorpk2.jpg
ATTACHED XREFS: BEND, OREGON



PROJECT NO. 0808 AM
DRAWN: OCTOBER 2008
DRAWN BY: GRS
CHECKED BY: RWJ
FILE NAME: kaczmarekOct08.dwg

CLAIM OF BENEFICIAL USE MAP

KACZMAREK WATER RIGHTS
FRYREAR RANCH ROAD
BEND, OREGON

FIGURE

1