
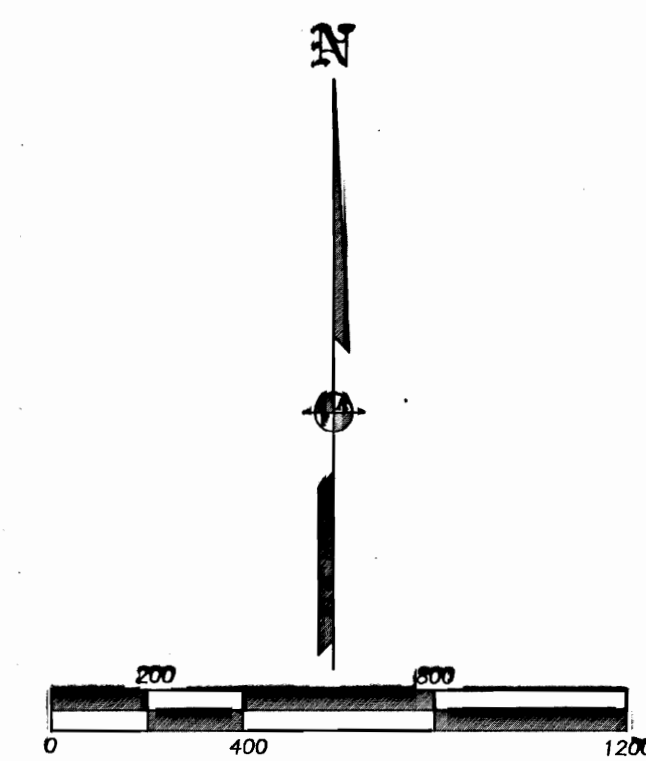


FINAL PROOF MAP UNDER T-11233

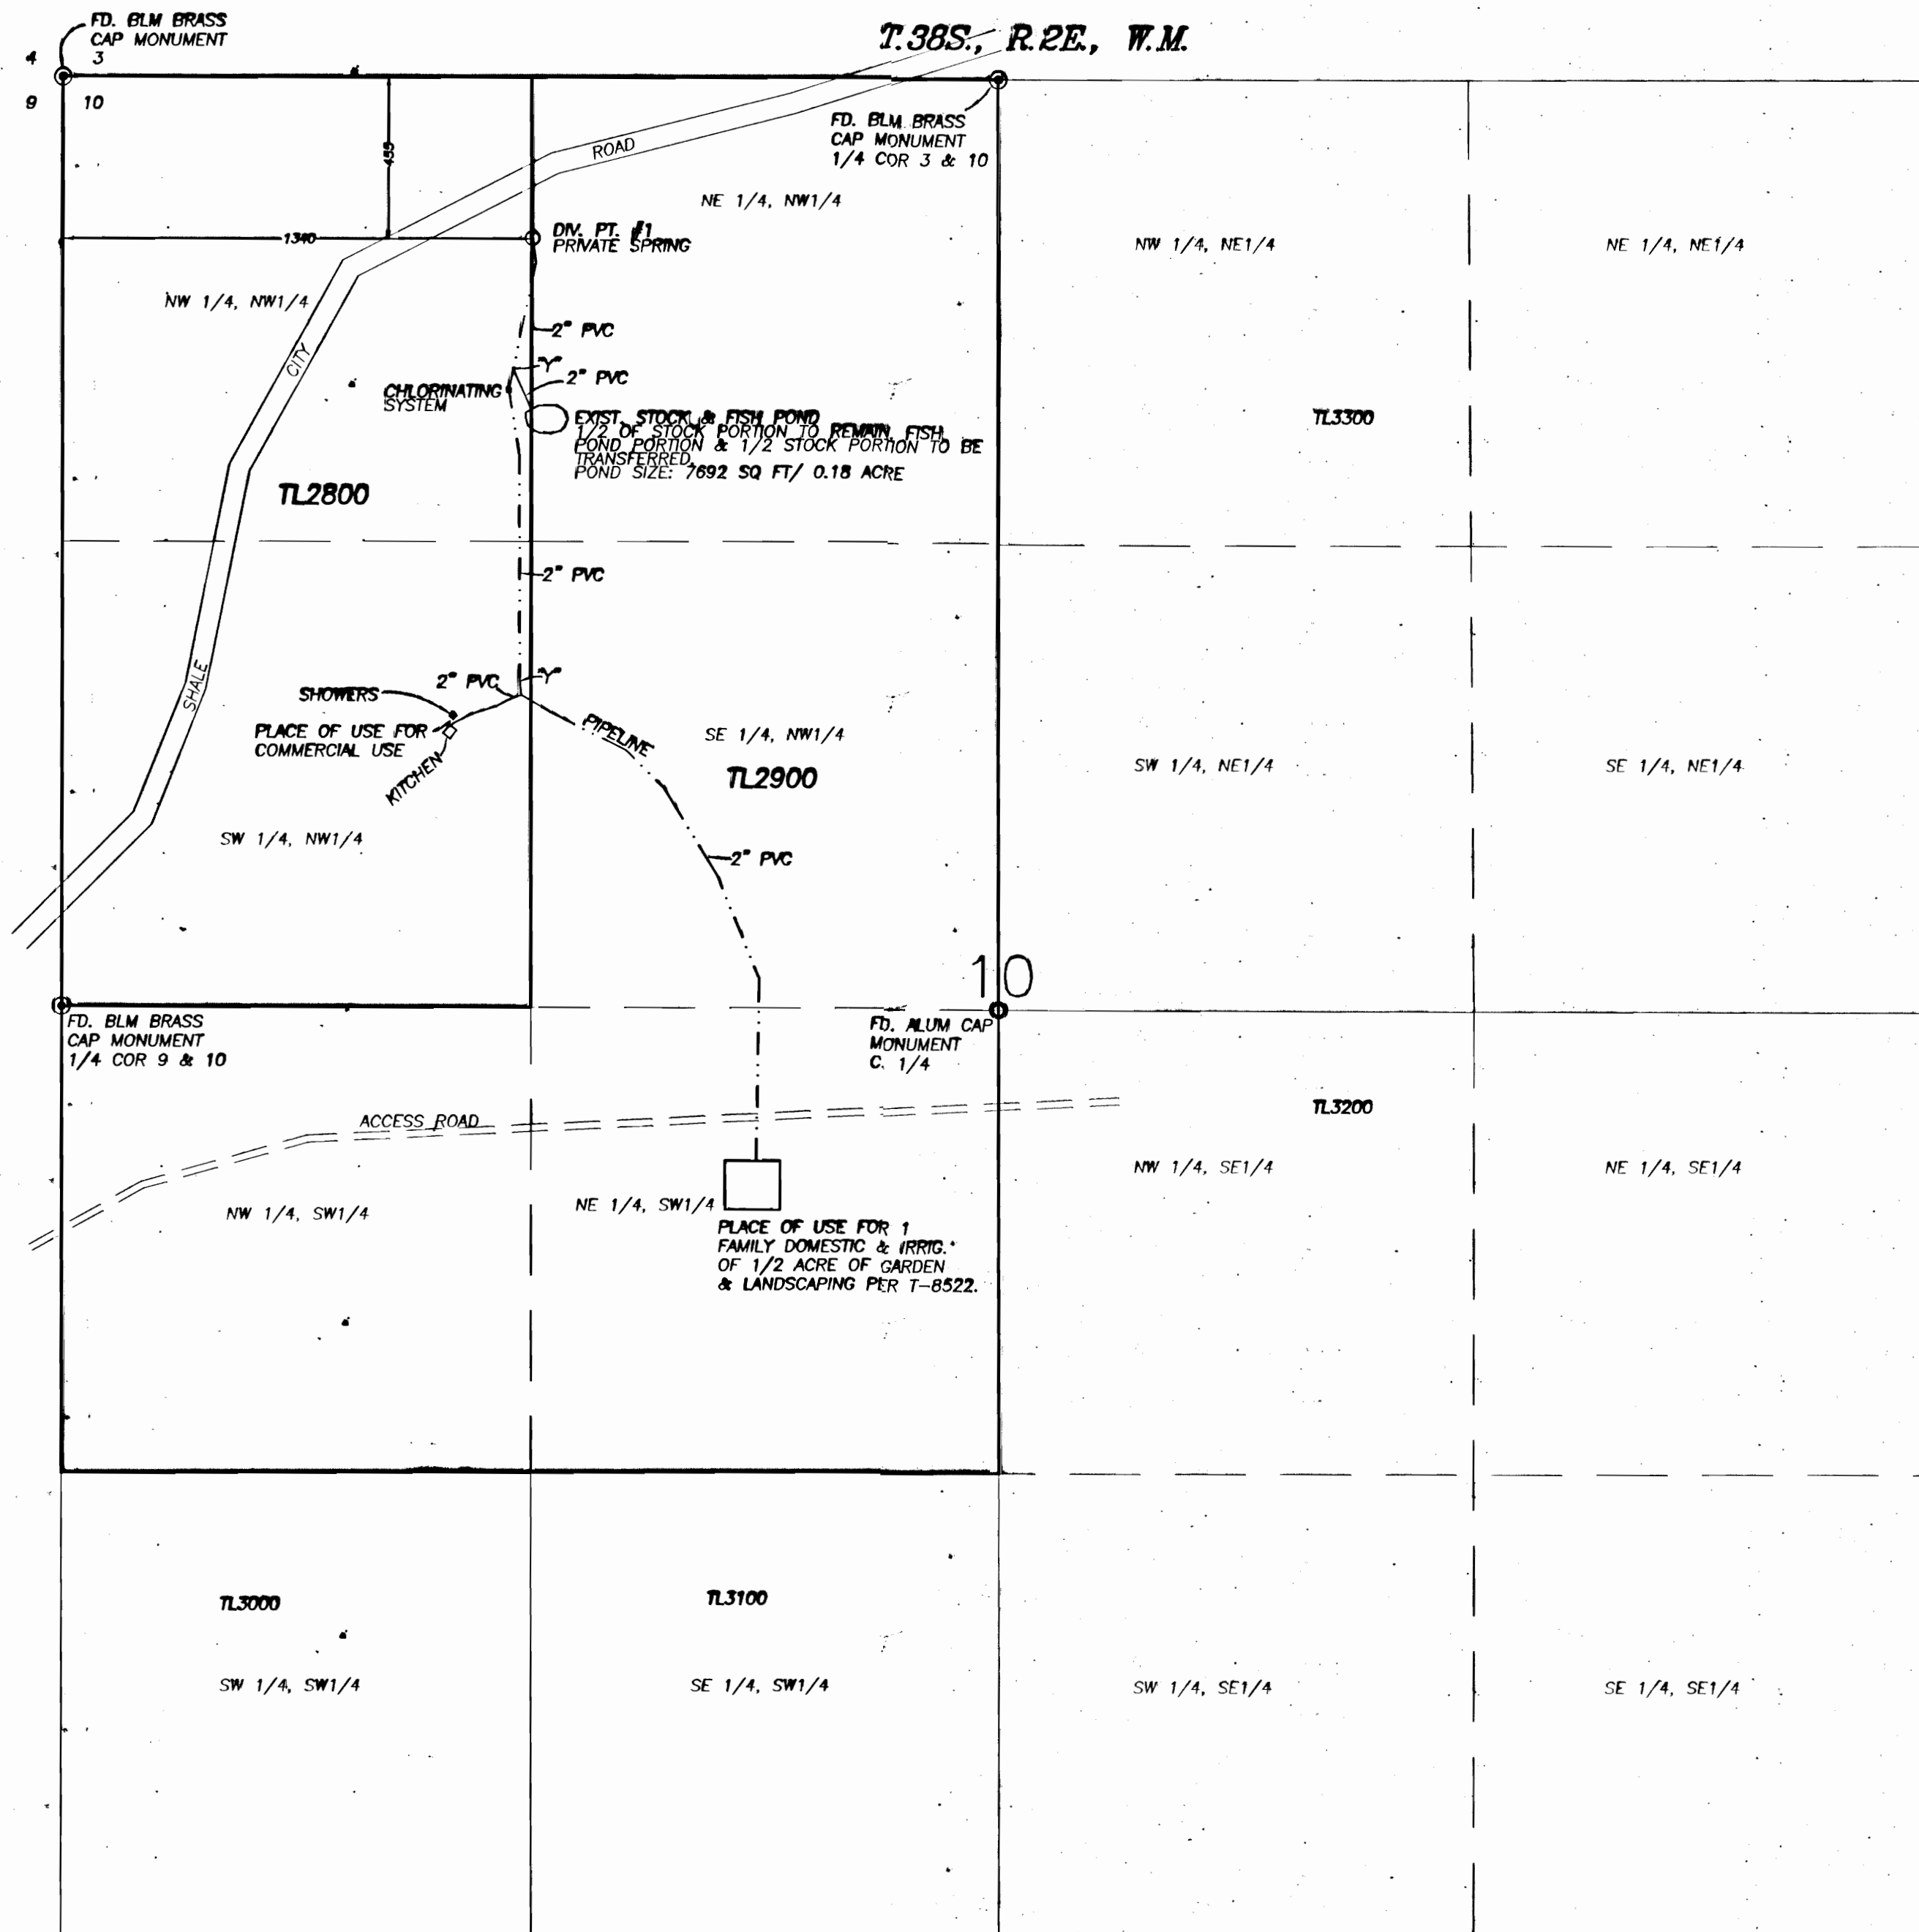

RECEIVED
OCT 12 2012
WATER RESOURCES DEPT
SALEM, OREGON

THE PREPARATION OF THIS MAP
IS TO IDENTIFY THE WATER RIGHT
ONLY AND IS NOT INTENDED TO
PROVIDE LEGAL DIMENSIONS OF
PROPERTY OWNERSHIP LINES.

COBU MAP # 722

382E10 TL'S 2800 & 2900

	TITLE: FINAL PROOF MAP UNDER T-11233 ASSESSOR'S MAP # 382E(10) TL'S 2800 & 2900	DATE: 13 aug 2012 SCALE: 1 inch = 400 feet
	FOR: WITT & WILLOW, LLC 658 SHALE CITY ROAD ASHLAND, OR 97520 PH: (541) 890-1998	DRAWN BY: JEH CHK BY: ORIGIN:
L.J. FRIAR & ASSOCIATES P.C. CONSULTING LAND SURVEYORS P.O. Box 1947, Phoenix, OR 97535 Phone: (541) 772-2782 Email: lfriar@charter.net	ROTATION: 0 JOB#: 11110PM Sheet 1 of 1	

722