

AUG 22 2011

CLAIM OF BENEFICIAL USE AND FINAL PROOF MAP

WATER RESOURCES DEPT

SALEM, OREGON



ELIZABETH PARRISH

FOR

CRYSTAL WOOD LODGE

T34S, R 06E, Sec. 26, W.M.
KLAMATH COUNTY, OREGON

TRANSFER T-7522

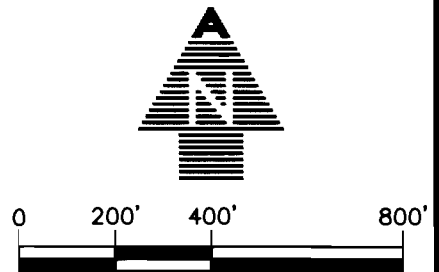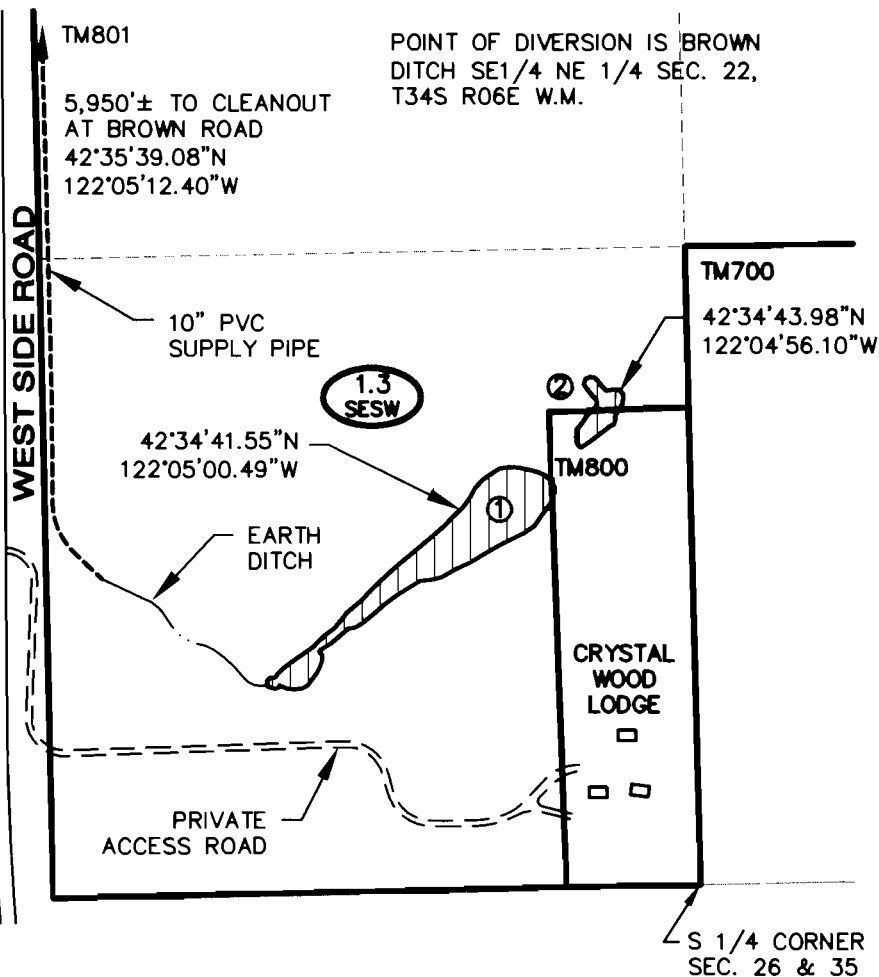



SCALE: 1" = 400'

NOTES:

1. THIS MAP WAS PREPARED FROM FIELD MEASUREMENTS, NAIP 2005 AERIAL PHOTOGRAPH AND KLAMATH COUNTY TAX MAP 340626.
2. THE PURPOSE OF THIS MAP IS TO IDENTIFY THE LOCATION OF THE WATER RIGHT ONLY, AND IS NOT INTENDED TO PROVIDE DIMENSIONS OR LOCATION OF PROPERTY LINES.
3. DATE OF PRIORITY FOR THIS APPLICATION IS AUGUST 10, 1995.
4. LAT. AND LONG. COORDINATES FOR P.O.D. AND FISH SCREEN; 42°35'56.00N, 122°05'40.56W.

- ① SOUTH POND—N 33°20' W, 920' FROM THE SOUTH 1/4 CORNER SECTION 26. SURFACE AREA OF POND WHEN FULL = 1.1 AC'S.
- ② NORTH POND—N 9°02' W, 1,040' FROM THE SOUTH 1/4 CORNER SECTION 26. SURFACE AREA OF POND WHEN FULL = 0.2 AC'S.

Elizabeth Parrish
Applicant signature

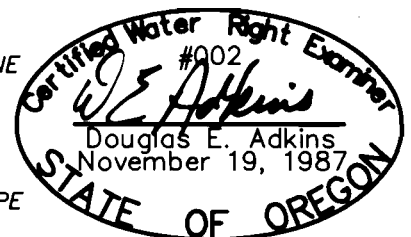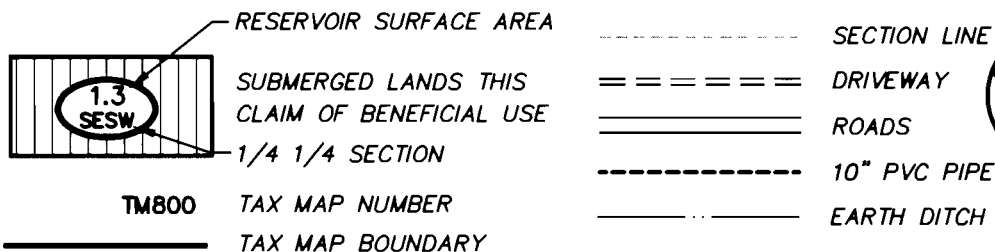LEGEND

RENEWAL 1/1/13

ADKINS

SINCE 1983

CONSULTING
ENGINEERS, INC.

Engineers ▲ Planners ▲ Surveyors

2950 Shasta Way · Klamath Falls, Oregon 97603 · (541) 884-4666 · FAX (541) 884-5335
Klamath Falls, Oregon

8/4/11

Parrish-Base

2394-01

**Claim of Beneficial Use
and Final Proof Map**

for

**ELIZABETH PARRISH
CRYSTAL WOOD LODGE
Klamath County, Oregon**