


T.39&40S. R.41E. W.M.

RECEIVED
SEP 18 2001
WATER RESOURCES DEPT.
PORTLAND, OREGON

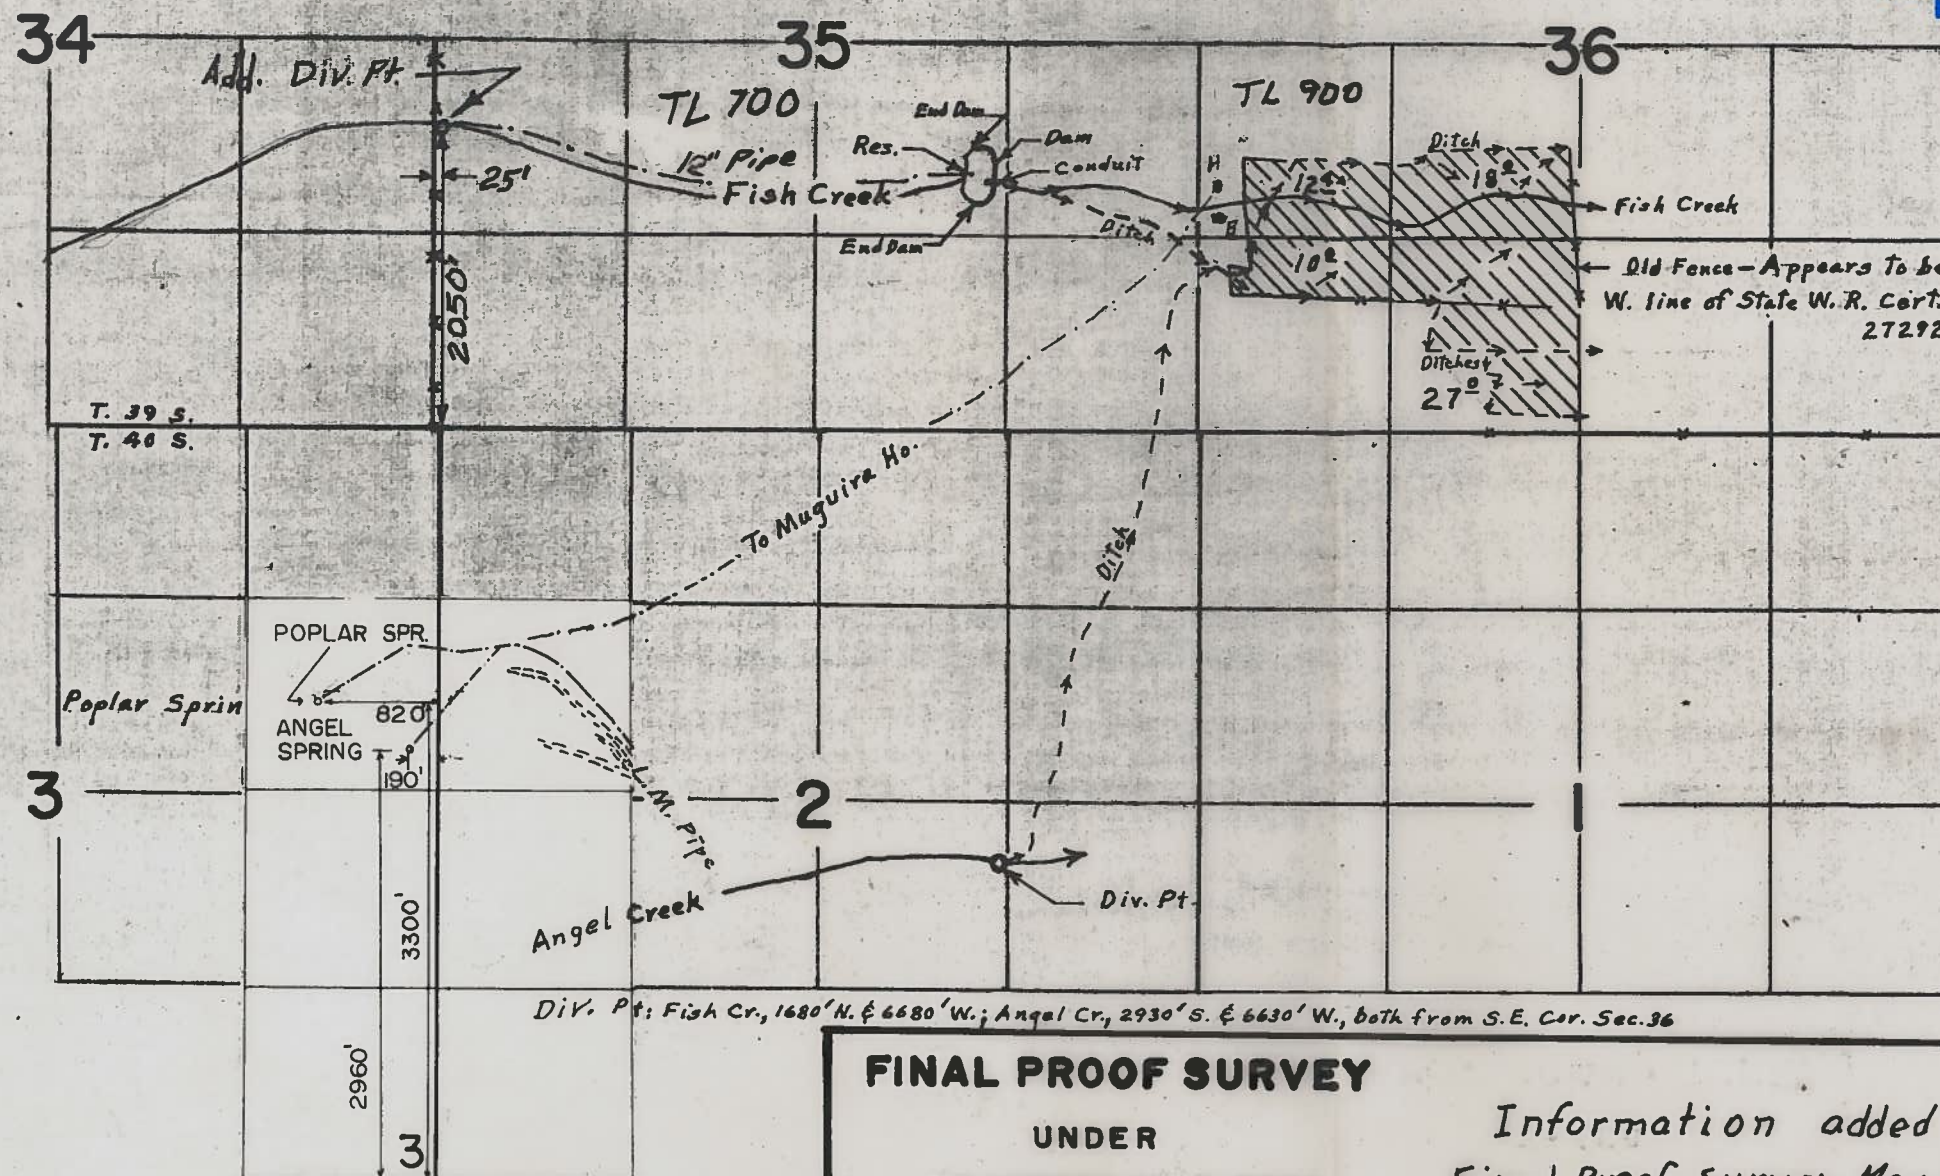

FINAL PROOF SURVEY

APPLICATION 41791
40926

PERMIT 31285
30535

BUREAU OF LAND MANAGEMENT

SURVEYED JUNE 17, 1976
JULY 18, 1985

BY L.E. GOULD
L. TOLL

THIS MAP WAS PREPARED FOR THE
PURPOSE OF IDENTIFYING THE LOCATION
OF A WATER RIGHT ONLY AND IS
NOT INTENDED TO PROVIDE LEGAL
DIMENSIONS OR LOCATION OF PROPERTY
OWNERSHIP LINES.

FINAL PROOF SURVEY

UNDER

TRANSFER NO. T-7770

FINAL PROOF SURVEY

UNDER

Application No. 41831 Permit No. 31960

IN NAME OF

CLETO MUGIRA

Surveyed June 14, 1976, by L. E. Gould

Information added to these
Final Proof Survey Maps are
from the applicant and the
USGS Quadrangle maps for
Bowden Waterhole & Oregon
Canyon Ranch.
INSPECTED SEPT. 4, 2001, BY

