


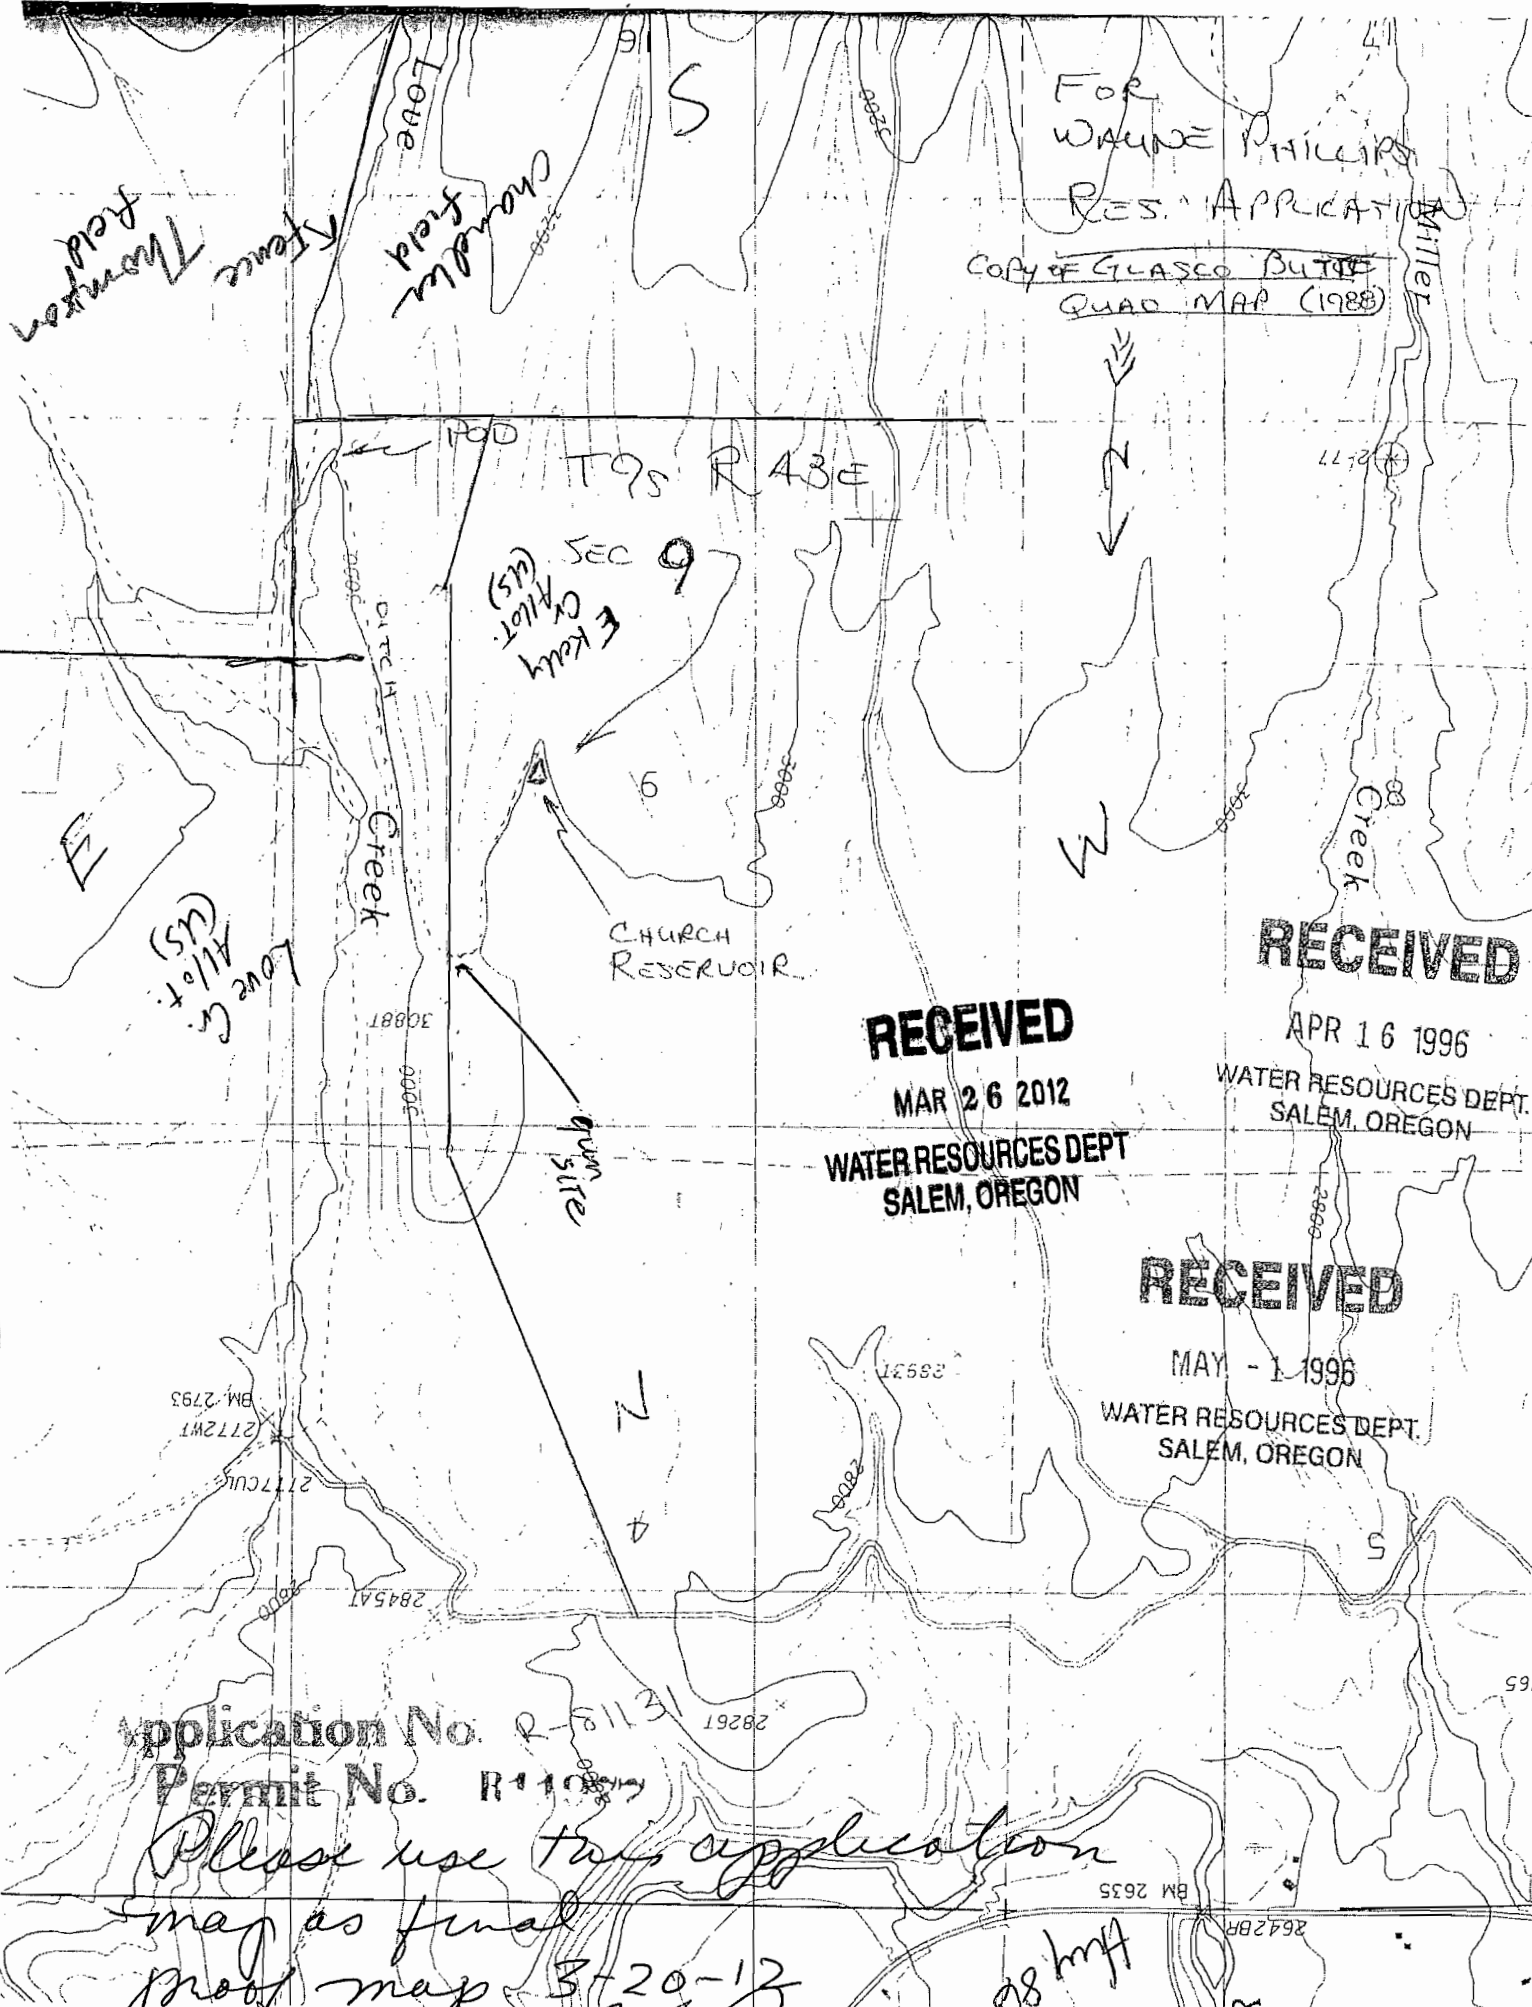

FOR
WAYNE PHILLIPS
RES. APPLICATION

COPY OF GLASCO BUTTE
QUAD MAP (1988)

T9S R43E

SEC 9
E Kelly
(US) Creek

CHURCH
RESERVOIR

RECEIVED

MAR 26 2012

WATER RESOURCES DEPT.
SALEM, OREGON

RECEIVED

APR 16 1996

WATER RESOURCES DEPT.
SALEM, OREGON

RECEIVED

MAY - 1 1996

WATER RESOURCES DEPT.
SALEM, OREGON

Application No. R-81131

Permit No. R-11087

Please use this application
map as final
proof map 3-20-12
Jeff Phillips