


T. 17S., R. 20E., W.M.

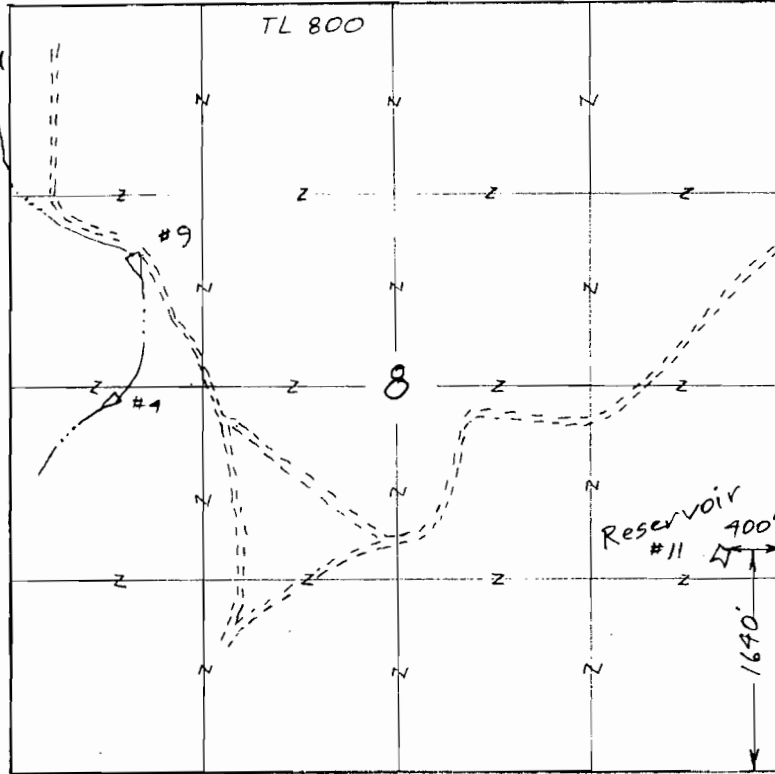

Scale 1" = 1320'
(4" = 1 mile)

Surveyed July 7, 2011

Claim of Beneficial Use Map
for
SHOTGUN RANCH, LLC


App R-87093

Per R-14639 (Res. #11)

RECEIVED

MAR 12 2012

WATER RESOURCES DEPT
SALEM, OREGON

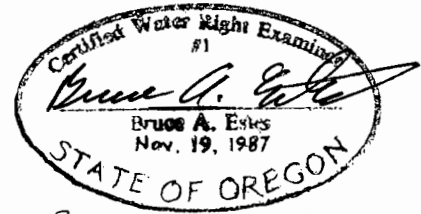

Renewal Dec 31, 2013

This map is for the purpose of
locating a water right only
and has no intent to provide
legal dimensions or the location
of property lines.

ESTES SURVEYS, LLC

~~PO Box 17519~~
Salem, OR 97306-7519
(503) 535-7593

60382 Arnold Rd
Bend, OR 97702
(541) 382-7391