


T. 17 S., R. 20 E., W. M.

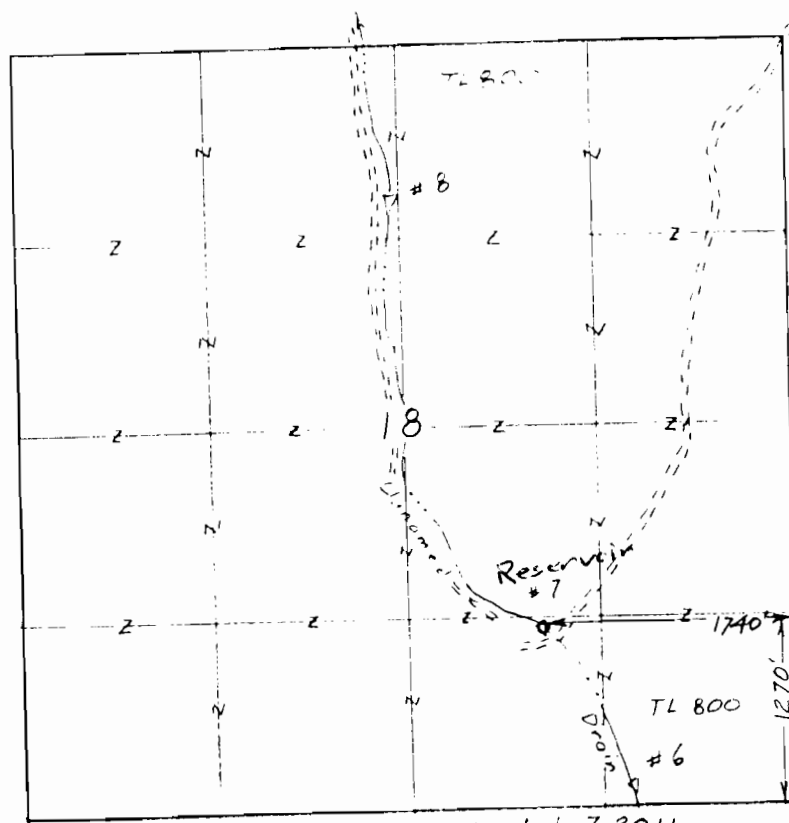

Scale 1" = 1320'
(1" = 1 mile)



Surveyed July 7, 2011

RECEIVED


MAR 12 2012

WATER RESOURCES DEPT
SALEM, OREGON

Claim of Beneficial Use Map
for
SHOTGUN RANCH, LLC

App R-87089

Per R-14635 (Res. #7)

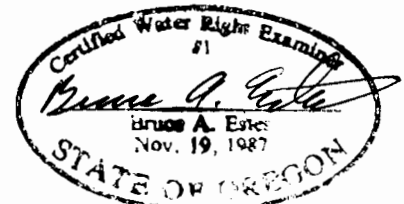

Renewal Dec 31, 2013

This map is for the purpose of locating a water right only and has no intent to provide legal dimensions or the location of property lines.

ESTES SURVEYS, LLC

PO Box 17515
Salem, OR 97305-7510
(503) 586-7503

60352 Arnold Rd
Bend, OR 97702
(541) 382-7391