


T. 17S., R. 20E., W. M.

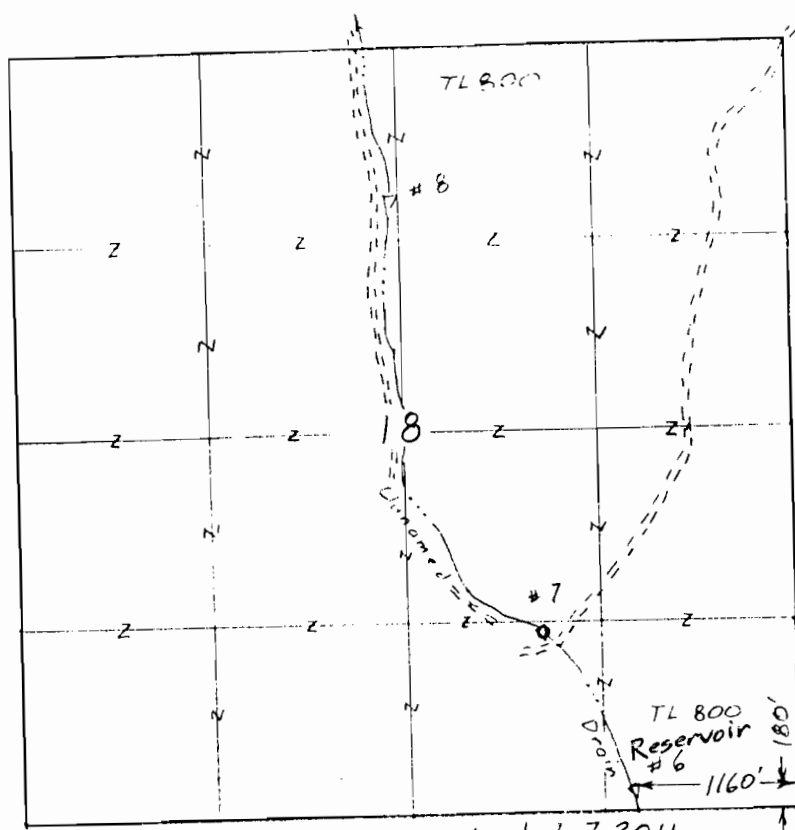

Scale 1" = 1320'
(1" = 1 mile)



Surveyed July 7, 2011

Claim of Beneficial Use Map
for
SHOTGUN RANCH, LLC


RECEIVED

MAR 12 2012

WATER RESOURCES DEPT
SALEM, OREGON

App R-87088

Per R-14634 (Res. #6)

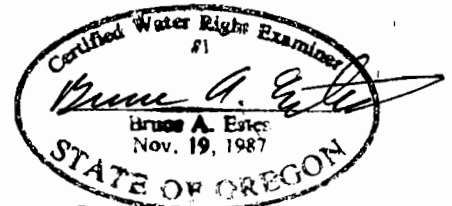

Renewal Dec 31, 2013

This map is for the purpose of
locating a water right only
and has no intent to provide
legal dimensions or the location
of property lines.

ESTES SURVEYS, LLC

PO Box 47515	60352 Arnold Rd
Salem, OR 97306-7510	Bend, OR 97702
(503) 586-7503	(541) 382-7391