


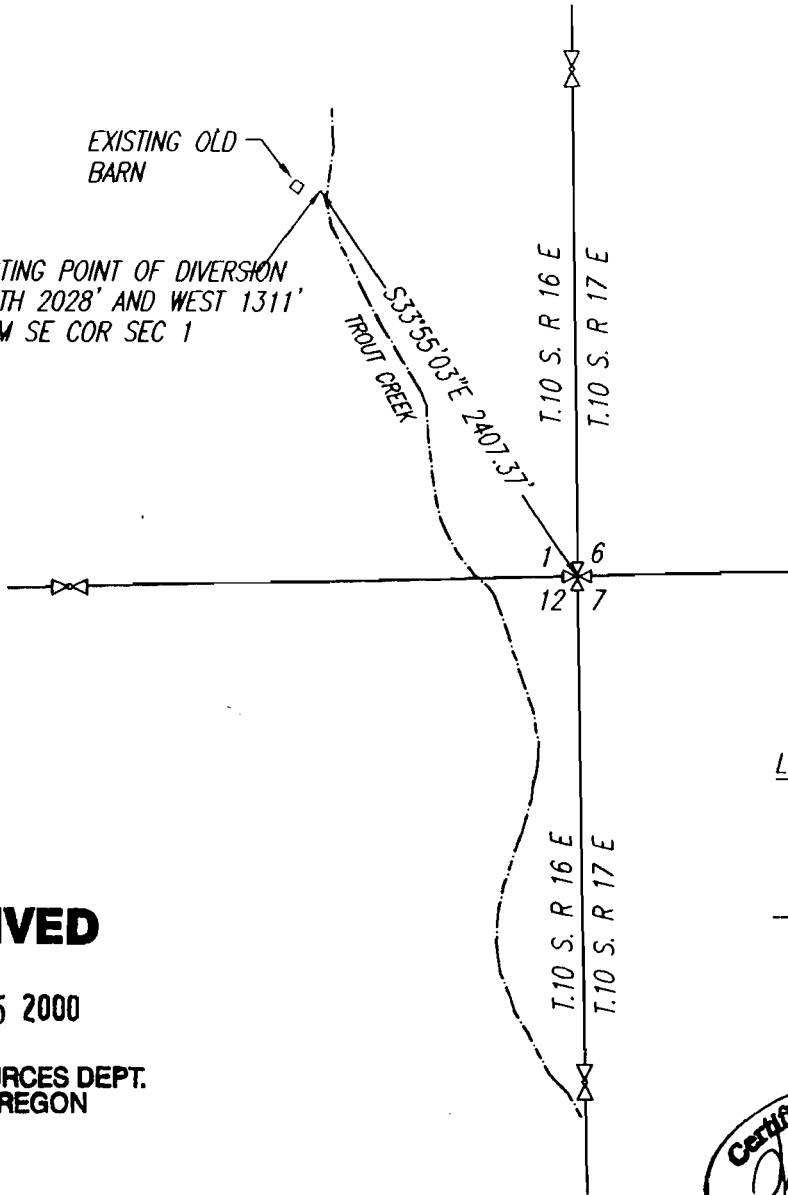


EXISTING OLD BARN

EXISTING POINT OF DIVERSION
NORTH 2028' AND WEST 1311'
FROM SE COR SEC 1



SCALE 1" = 1000'

LEGEND

-  SECTION CORNER
-  QUARTER CORNER
-  APPROXIMATE C/L OF TROUT CREEK

RECEIVED

MAY 25 2000


WATER RESOURCES DEPT.
SALEM, OREGON

I, Joel G. Smith, Water Rights Examiner No. 120, do hereby certify that this water rights map was prepared under my supervision.


The location of the point of diversion was measured by compass and pacing. This map is intended to show the location of the water diversion and does not accurately depict property boundaries.

This map to be read in conjunction with "Site Report" attached.

DRAWING NO: H1231-2
DATE: 5/23/00

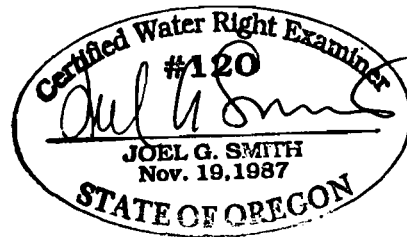

RENEWS 6/30/00

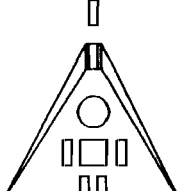	TERRASCOPE, INC. 405 SW Eighth St Redmond, OR 97756 Tel: (541) 548-7852 Fax: (541) 548-7854
---	---

FINAL PROOF SURVEY
DIVERSION LOCATION MAP
CERTIFICATE NO. 2250
SECTION 1, T10S, R 16E, WM
JEFFERSON CO., OREGON