
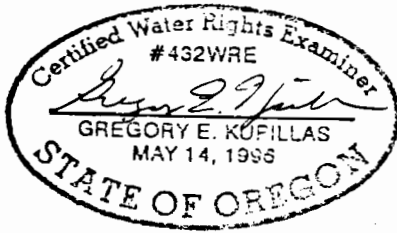


T.6S. R.1W. Section 21, W.M.

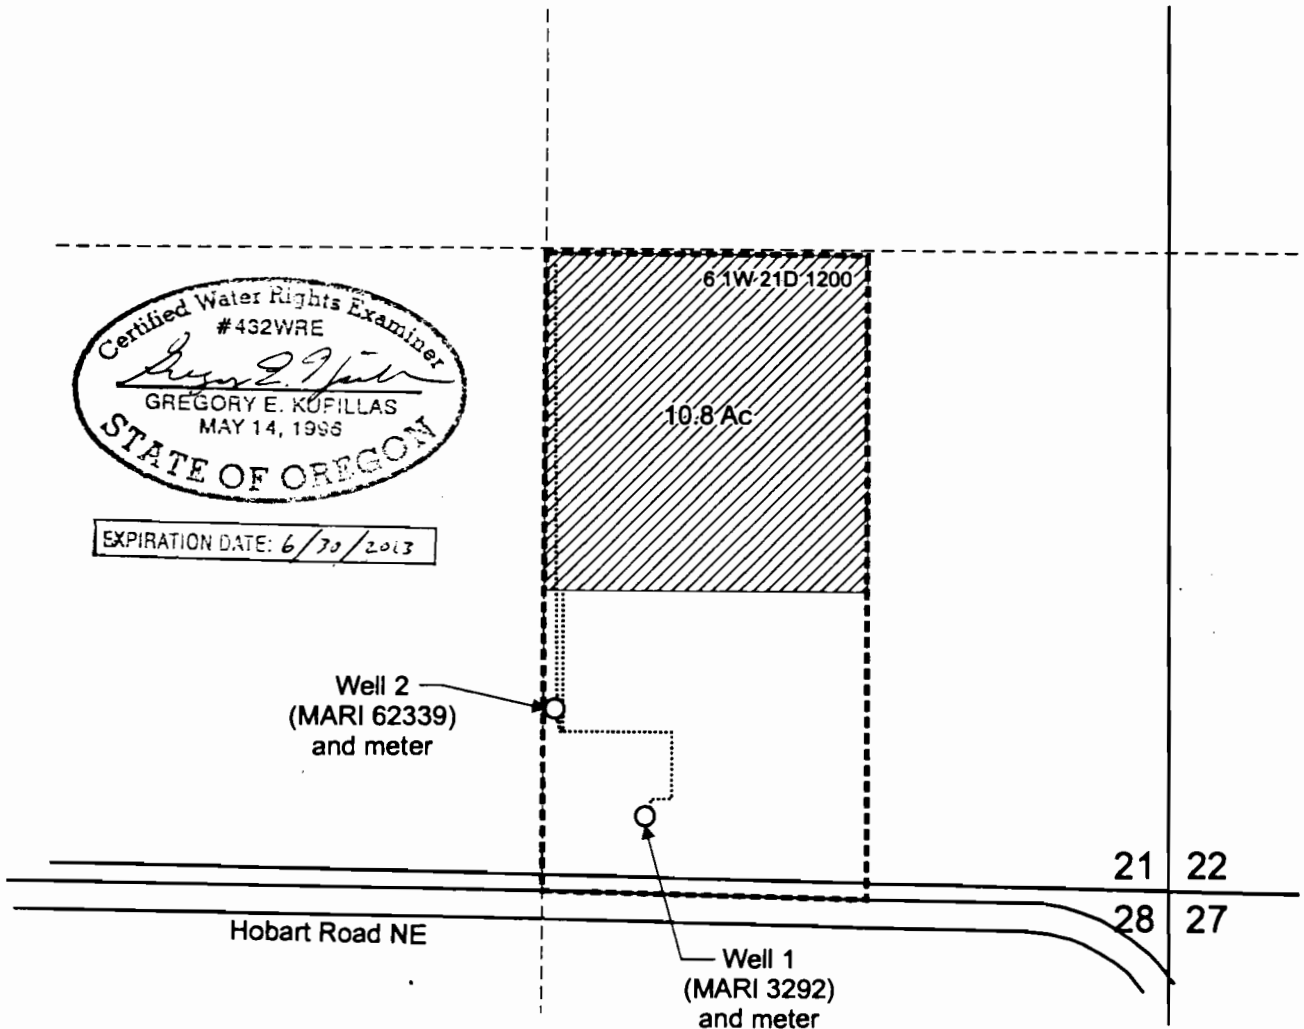

EXPIRATION DATE: 6/30/2013

Well 1 (MARI 3292) is located 150 feet north and 1,085 feet west from the SE corner, Section 21.
Well 2 (MARI 62339) is located 340 feet north and 1,275 feet west from the SE corner, Section 21.

 Area (10.8 Acres) irrigated under Application G-16906, Permit G-16416.

..... Irrigation mainlines

----- Tax lot boundary

Scale: 1" = 400'



This map was prepared for the purpose of identifying the location of a water right only and is not intended to provide legal dimensions or location of property ownership lines.



Claim of Beneficial Use Map
Application G-16906, Permit G-16416

Ellen Ann Snow
T.6S. R.1W. Sec. 21, W.M.

Pacific Hydro-Geology Inc.

01/2013 rev.