






**Claim of Beneficial Use
T-9434
T 36 S, R 1 W, Sec 4, W.M.**

**Map of Place of Use
T36S, R1W, Sec 4**

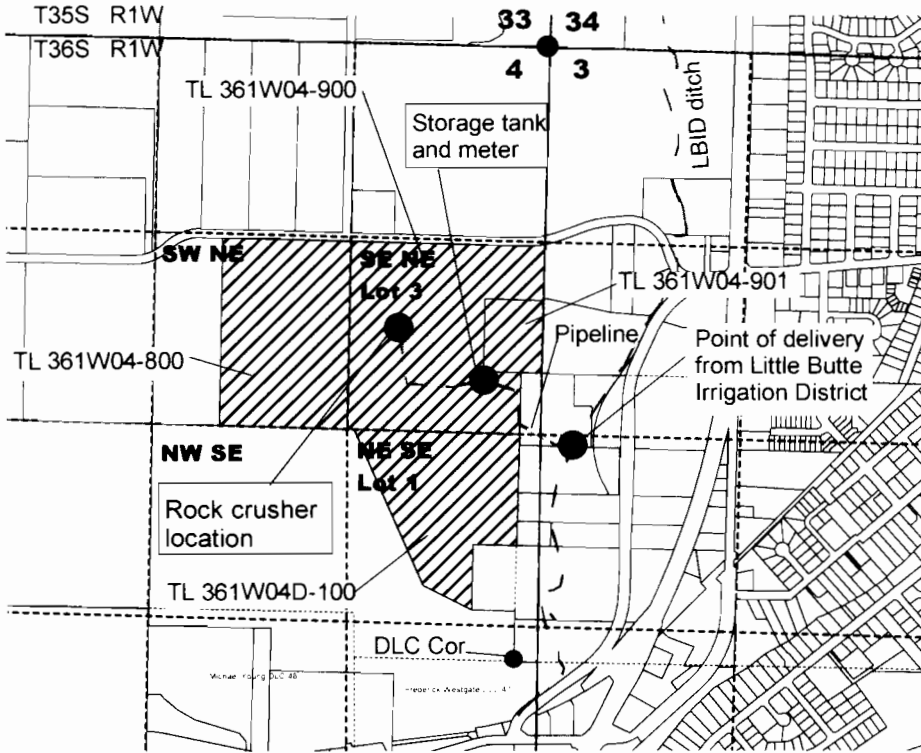


Legend

-  Mining water right coverage
-  Little Butte Irrigation District ditch
-  Section line
-  Quarter-quarter line




Scale 1" = 1320'

**Map of Point of Diversion
T35S, R1E, Sec 31**

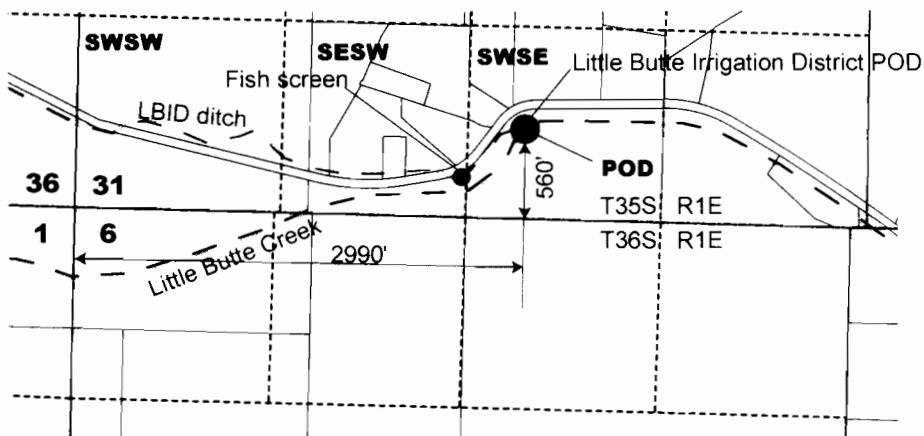

Note: This map is for water right purposes only. It is not to be used for property line location.

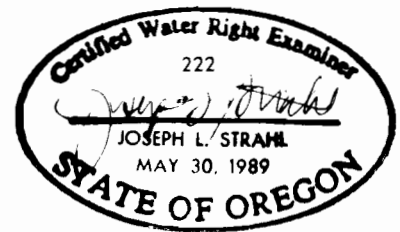

CWRE stamp

**Little Butte Irrigation District Point of Diversion
from Little Butte Creek**

Faint handwritten text at the bottom right of the page.