

Claim of Beneficial Use


T-10806

RECEIVED



AUG 25 2011

STATE OF OREGON
DEPARTMENT OF AGRICULTURE


8/18/2011

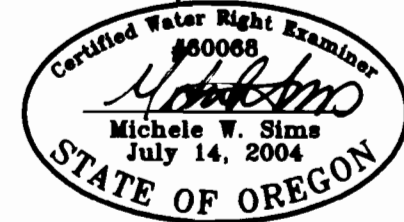

Renewal date: 6/30/2012

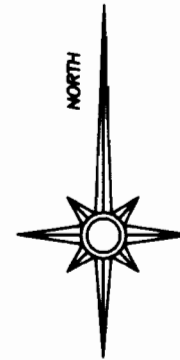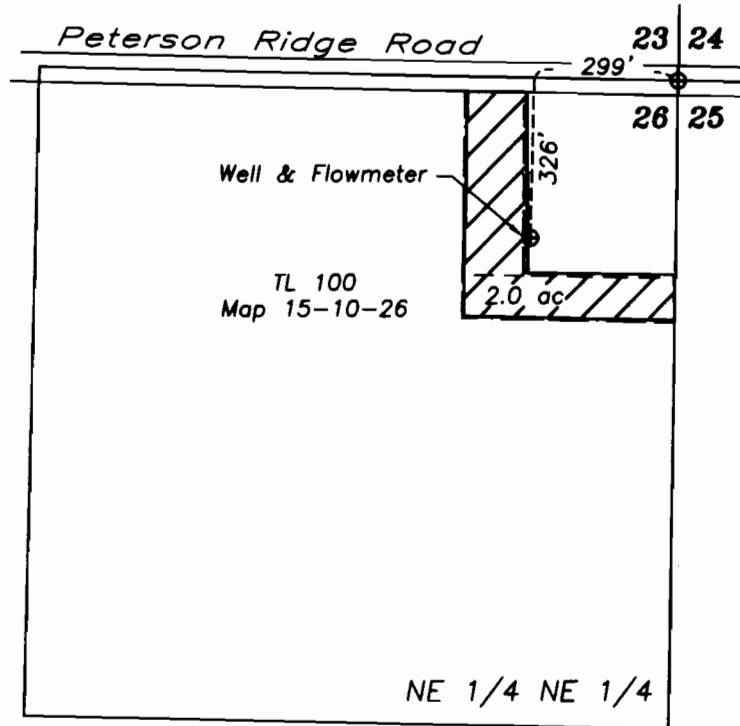


Legend

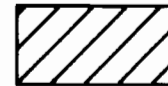


Water beneficially applied under transfer
T-10806 priority date 3/4/1980



Property line

 

Mainline

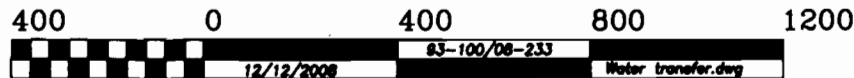

GRAPHIC SCALE - FEET

THIS MAP IS FOR THE PURPOSE OF IDENTIFYING THE LOCATION OF THE WATER RIGHT. IT IS NOT INTENDED TO PROVIDE LEGAL DIMENSIONS OR LOCATIONS OF PROPERTY OWNERSHIP LINES.