


T5N, R36E, WM
UMATILLA COUNTY

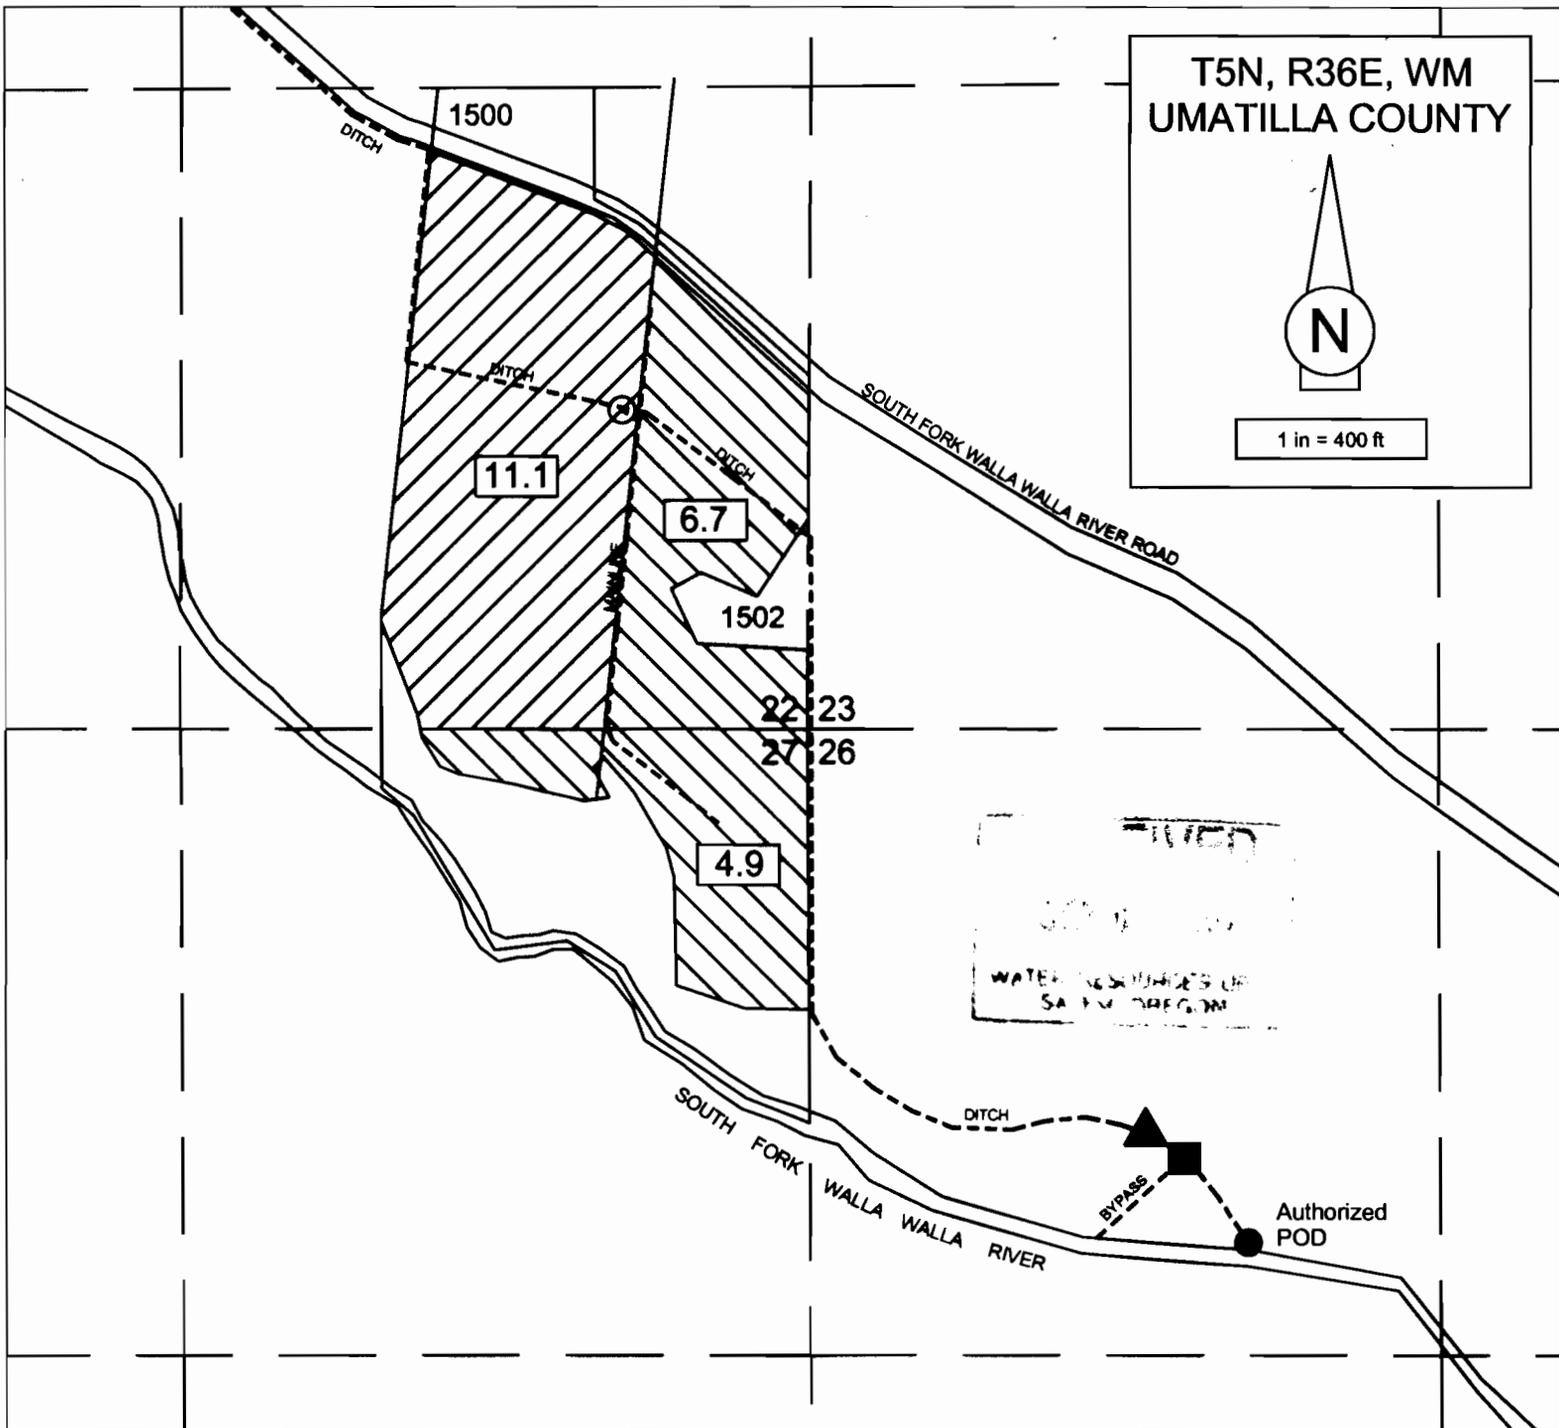


1 in = 400 ft



- POD is gravity diversion located in the NW/4, NW/4, Section 26, T5N, R36E, WM, at a distance 1080 feet South and 920 feet East from the NW Corner of Section 26.
- PUMP STATION includes two pumps that divert water from ditch into buried mainline for distribution throughout place of use (15 and 3 hp centrifugal pumps with flooded suction).
- ▨ PLACE OF USE is 11.1 acres in TL 1500 formerly a portion of Certificate 13177: 11.1 acres in SE/4, SE/4, Section 22 Currently growing apple trees, wine grapes, grass pasture and turfgrass.
- FISH SCREEN is hydraulically-driven drum screens with bypass to river.
- WATER CONVEYANCE Water is conveyed from river to pump station with open ditch (soil, gravel, grass surface) with 3-foot bottom width, 11-foot top width and 2-foot depth. Water conveyed from pump with 4-inch buried PVC mainline.
- ▨ PLACE OF USE is 15.8 acres in TL 1500 formerly a portion of Certificate 12714: 6.7 acres in SW/4, SW/4, Section 22 4.9 acres in NE/4, NE/4, Section 27 Currently growing apple trees, wine grapes and grass pasture.
- ▲ FLOW MEASUREMENT is galvanized steel flume installed in conveyance ditch downstream of fish screen.

The purpose of this map is to identify the location of a water right. It is not intended to provide information regarding the location of property ownership boundary lines.

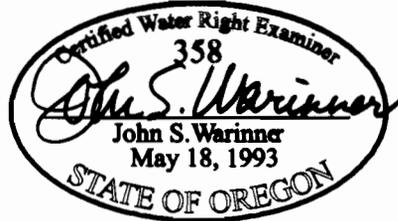

FOUNTAINHEAD
1860 Blue Creek Road
Walla Walla, WA 99362
Phone: 509.529.2646
Fax: 509.522.5251

FINAL PROOF SURVEY MAP
Transfer 8706
in the name of
Samuel and Heidi Wells
81768 South Fork WW River Road
Milton-Freewater, OR 97862
Revised by John Warinner 01 MAY 2006