


SECTION

TOWNSHIP 15 S, RANGE 14 E, W. M.

North

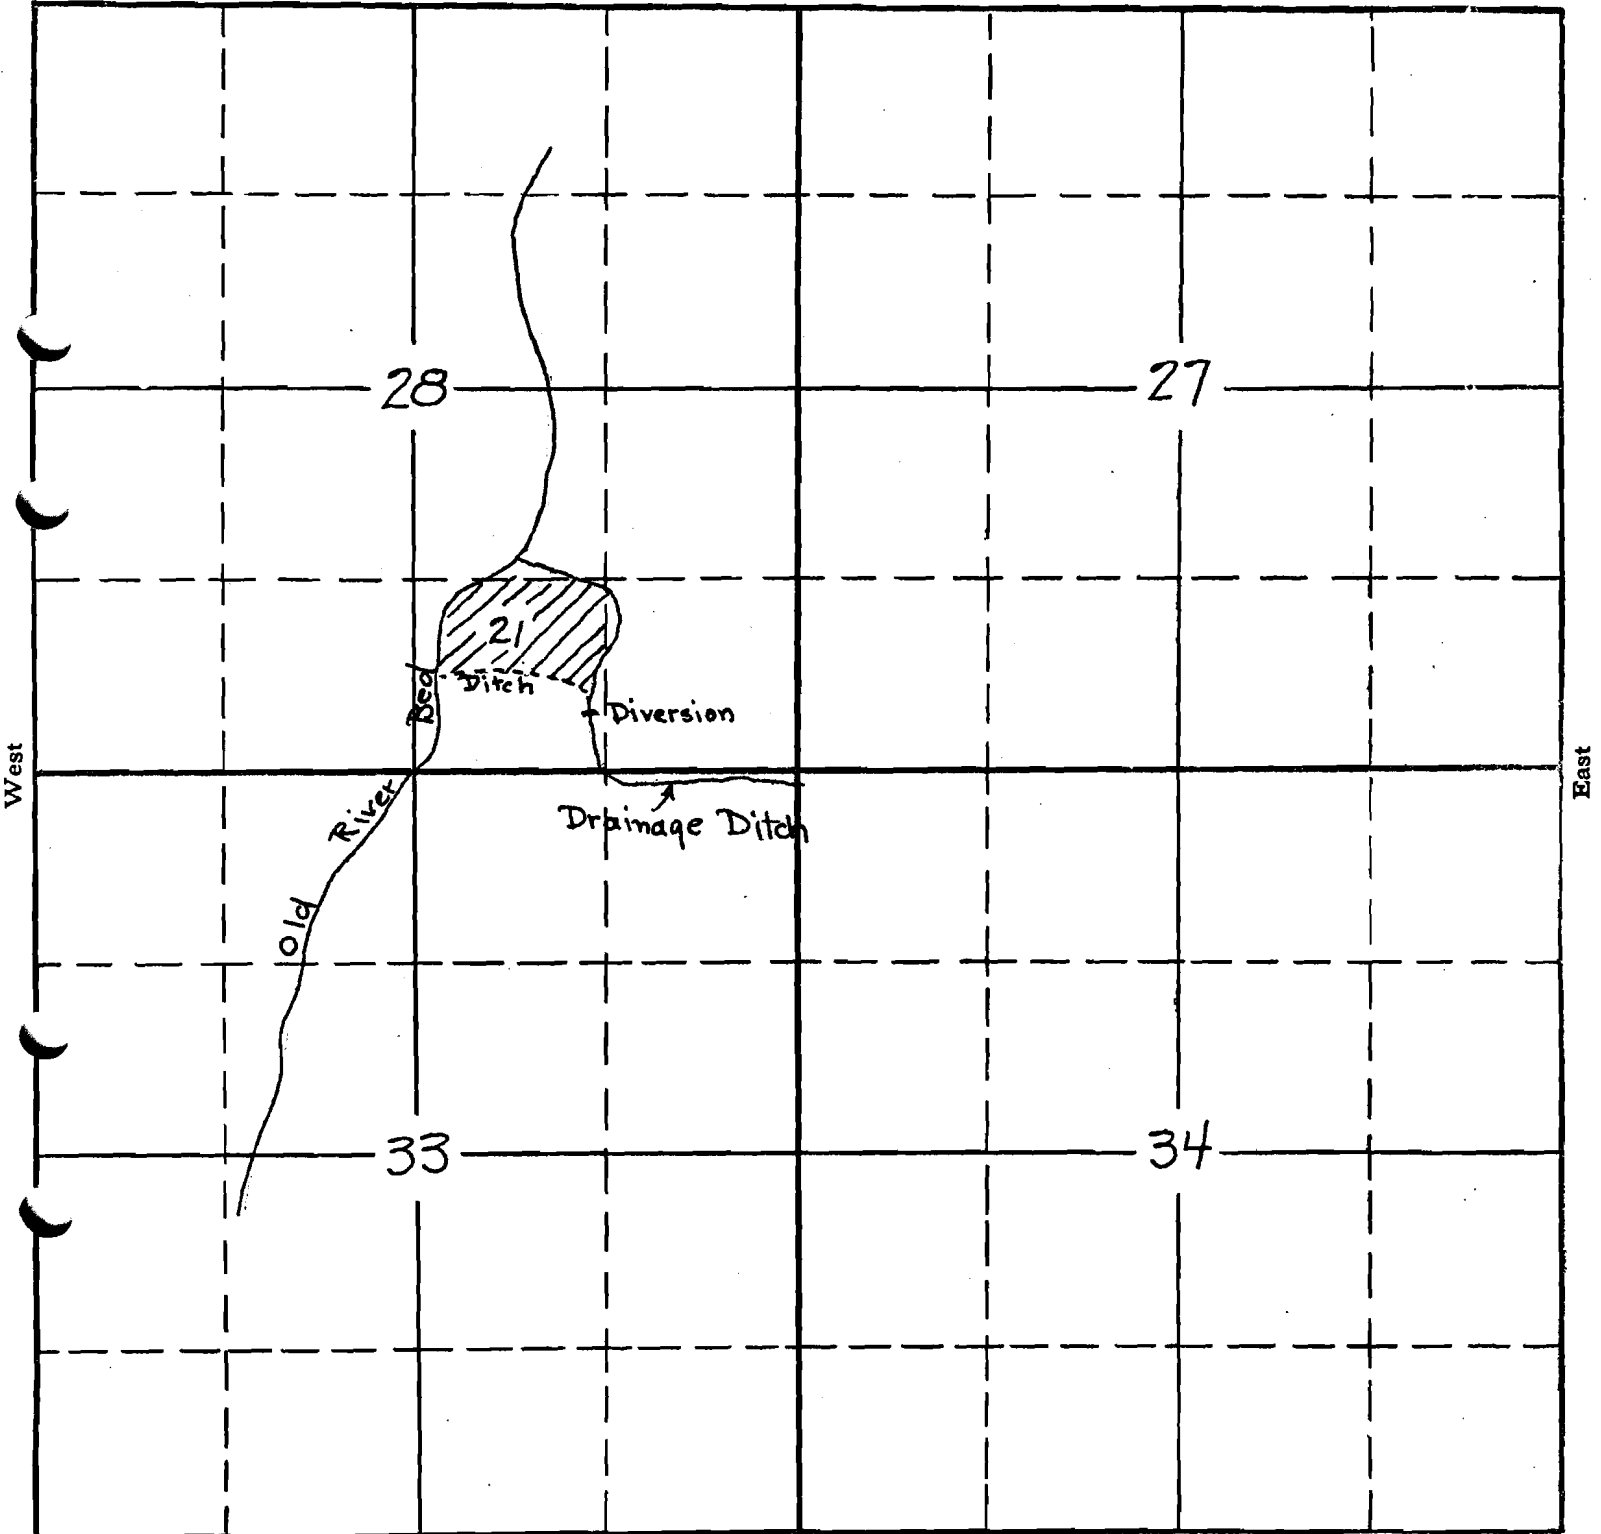

South

APPLICATION No. 13555

PERMIT No. 9731

C8855

9731