


FINAL PROOF MAP


TO TRANSFER RIGHTS AND
ADD A POINT OF APPROPRIATION
FOR T-10601

JERRY AND LINDA NEWMAN


TOWNSHIP 27 SOUTH, RANGE 16 EAST, SECTION 24, W.M.
TAX LOT: 600

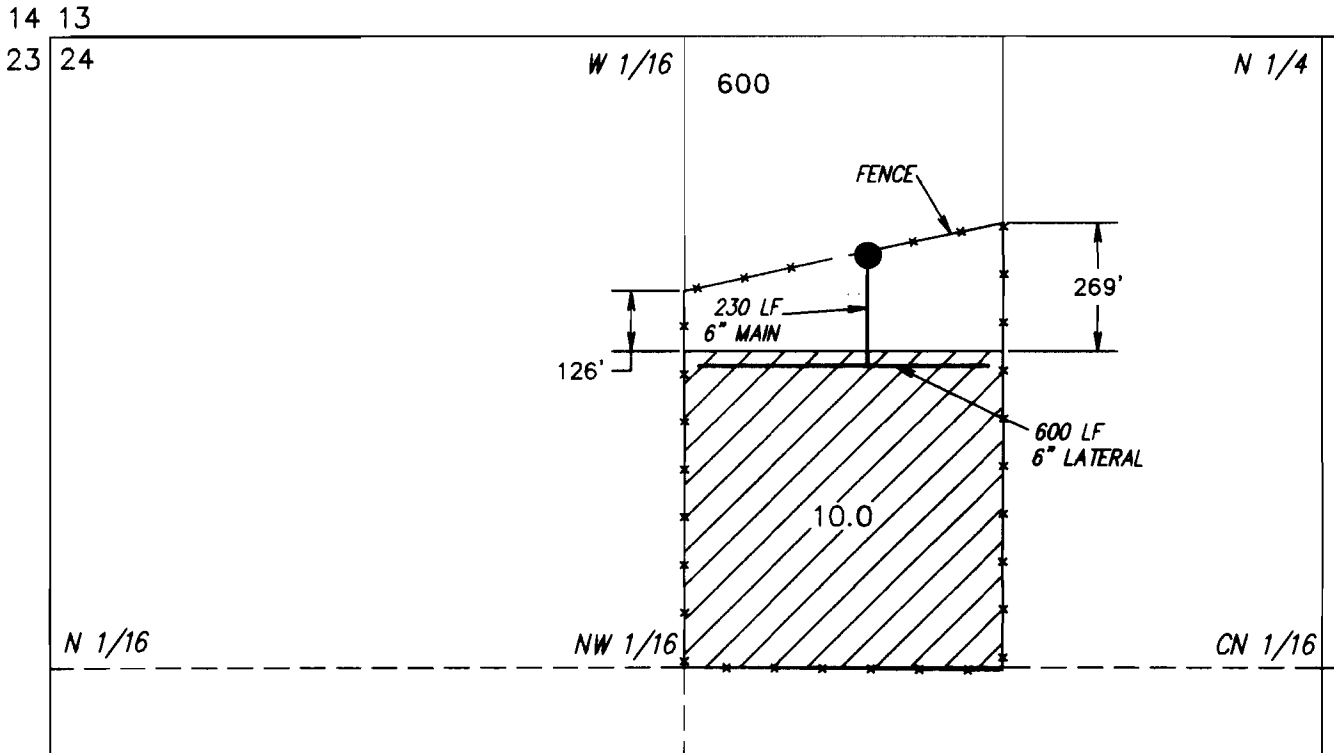

THIS MAP IS FOR THE PURPOSE OF LOCATING A WATER
RIGHT ONLY AND HAS NO INTENT TO PROVIDE LEGAL
DIMENSIONS OR THE LOCATION OF PROPERTY LINES

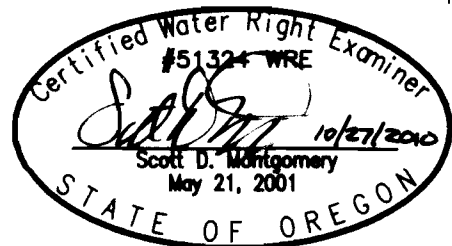

RENEWAL DATE: 12/31/2010

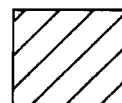

10.0 ACRES FROM G-9171 (CERT.# 53056)
TRANSFERRED AS SHOWN

NEW POA

NEW WELL IN THE NE1/4 OF THE NW1/4 OF
SECTION 24 LOCATED 480 FEET SOUTH AND 940
FEET WEST FROM THE NORTH 1/4 CORNER OF
SECTION 24, TOWNSHIP 27 SOUTH, RANGE 16 EAST,
W.M., LAKE COUNTY, OREGON

NEWLY INSTALLED METER IS APPROXIMATELY 5.0
FEET EAST ALONG DELIVERY PIPE FROM WELL.

PREPARED FOR:

JERRY AND LINDA NEWMAN
P.O. BOX 761
CHRISTMAS VALLEY, OR 97641

PREPARED BY:



ALL POINTS ENGINEERING AND SURVEYING, INC.
P.O. BOX 767 (CRR) TERREBONNE, OR 97760
(541) 548-5833
www.APEandS.com