

● **Point of Appropriation**

POA 1 is well in gravel aquifer (Well Log UMAT 4294) located in NW/4, NW/4, Section 19, T6N, R35E, WM, at a distance 830 ft S and 1335 ft E from NW Corner of Section 19. Flowmeter located immediately east of well.

POA 2 is well in gravel aquifer (Well Log UMAT 54472) located in NW/4, NW/4, Section 19, T6N, R35E, WM at a distance 670 feet South and 1300 feet East from NW Corner Section 19. Flowmeter located east of well.



Place of Use

152.6 acres in hay-grain rotation



Conveyance

10-inch and 6-inch buried PVC mainline with riser valves feeding aluminum handline equipped with brass impact sprinklers.


T6N, R35E, S19, WM
Umatilla County



1 inch = 400 feet

The purpose of this map is to identify the location of a water right. It is not intended to provide information regarding the location of property ownership boundary lines.

FOUNTAINHEAD
1860 Blue Creek Road
Walla Walla, WA 99362
(509) 529-2646 phone

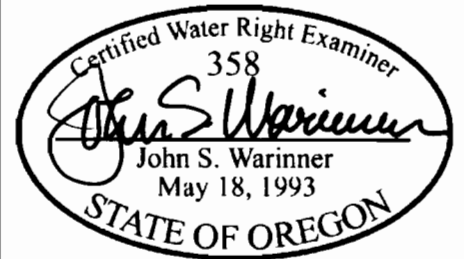

FINAL PROOF SURVEY MAP

Transfer 9514

in the name of
DOUG CASE

Revised 09 JAN 2008