


# TOWNSHIP 17 SOUTH, RANGE 22 EAST, W.M.

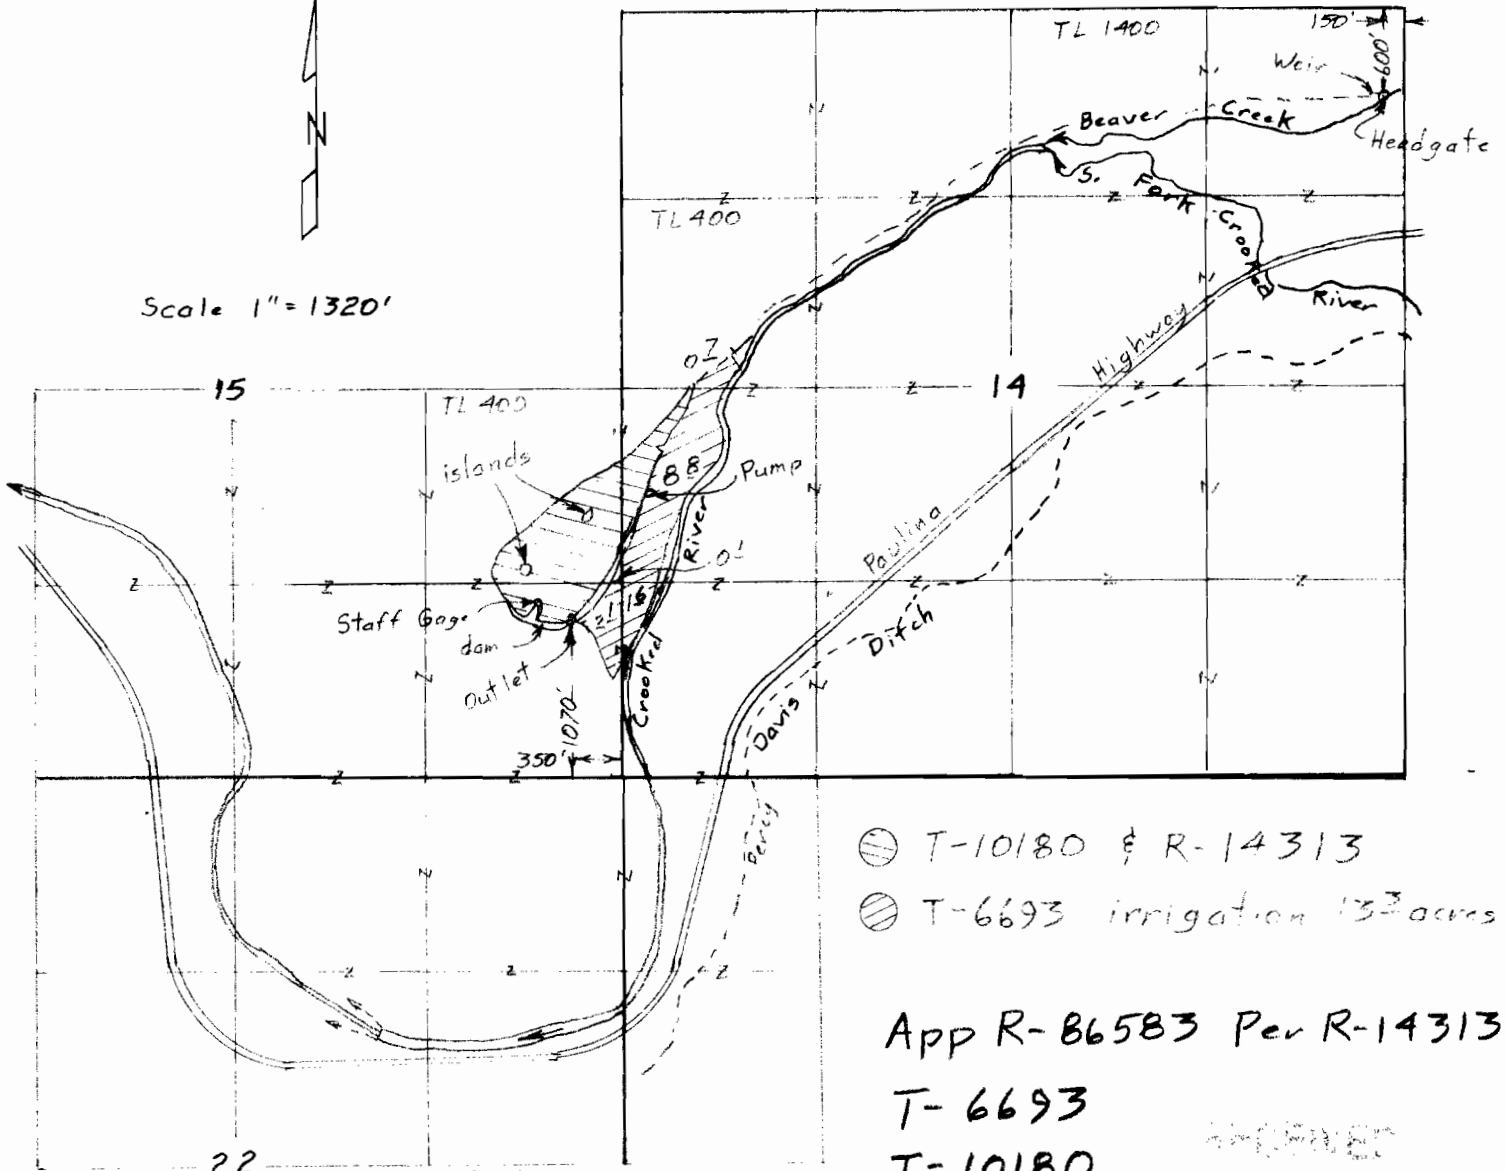

Scale 1" = 1320'




- ⊗ T-10180 & R-14313
- ⊗ T-6693 irrigation 133 acres

App R-86583 Per R-14313  
 T-6693  
 T-10180

Claim of Beneficial Use Map  
 for  
 OREGON RANCHING CO.  
 (Twin Buttes Ranch)

WATER RESOURCES DIVISION  
 JUL 24 1997

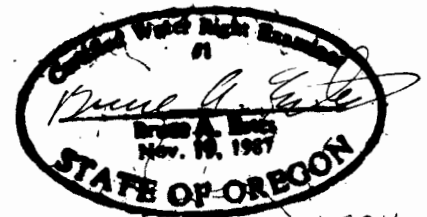

Renewal Dec 31, 2011

This map is for the purpose of locating a water right only and has no intent to provide legal dimensions or the location of property lines.

**ESTES SURVEYS, LLC**  
 PO Box 17515 Salem, OR 97305-7515 (503) 584-7503  
 80382 Arnold Rd Bend, OR 97702 (841) 382-7304