



FINAL PROOF SURVEY MAP FOR T-9100
 in the name of
 BONANZA VIEW DAIRY PARTNERSHIP
 T 39 S R 11 E, W.M.

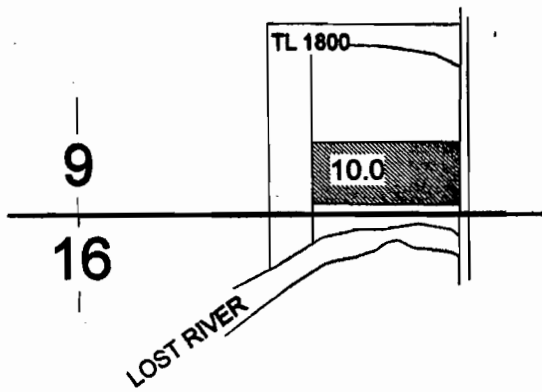

This map is for water
 right purposes only.

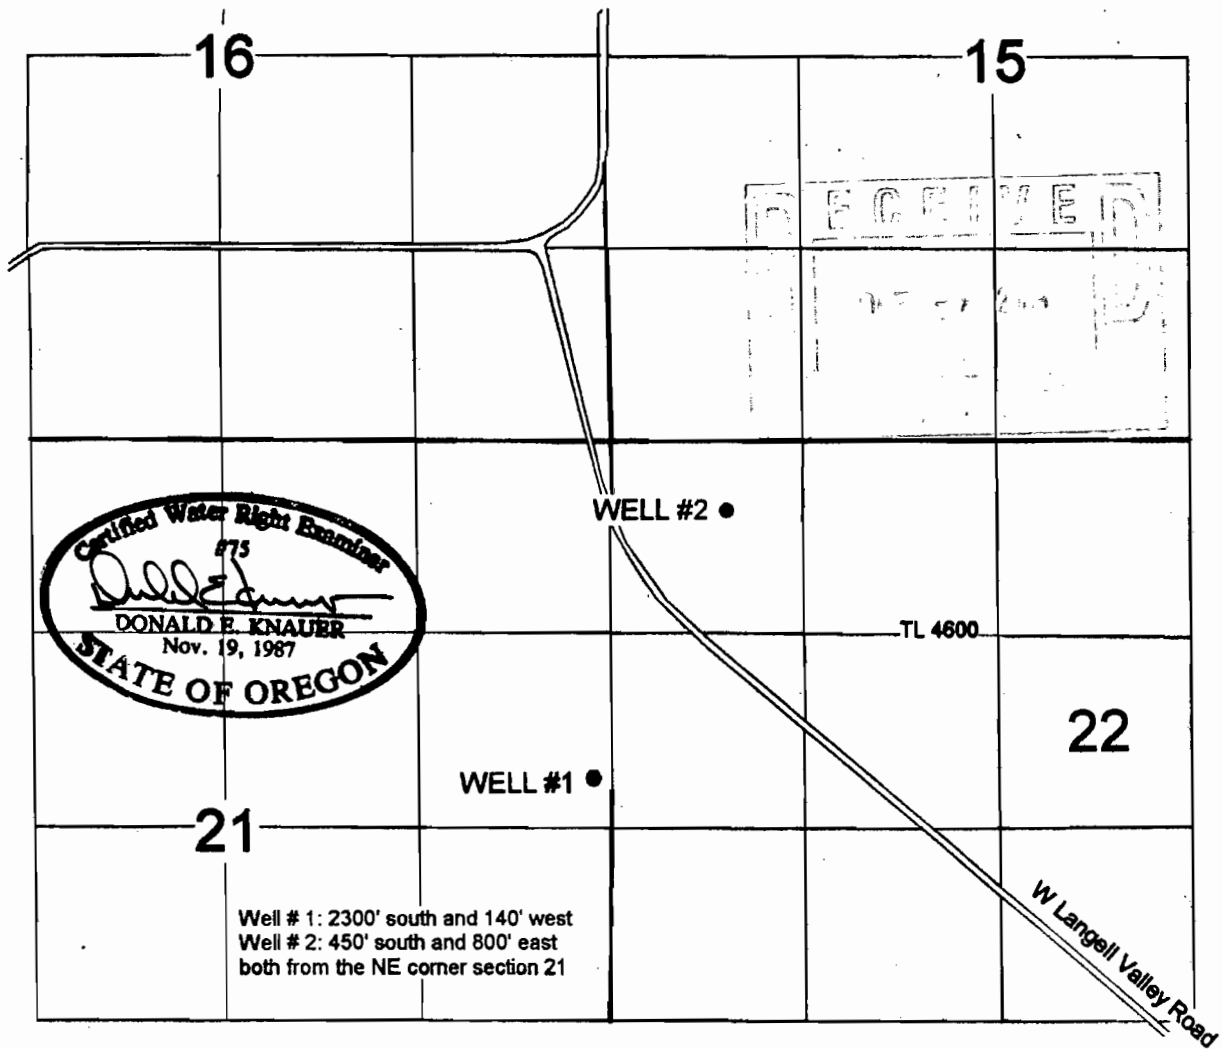

Well # 1: 2300' south and 140' west
 Well # 2: 450' south and 800' east
 both from the NE corner section 21

4" = 1 mile

